

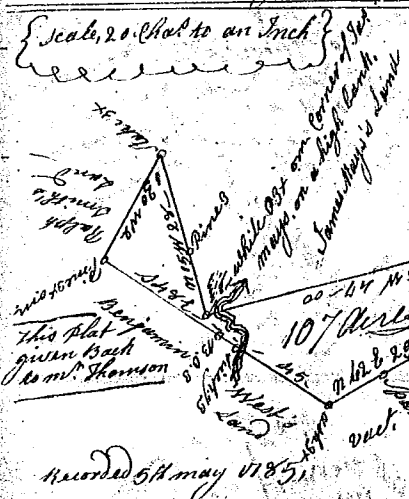


State of South Carolina Ninety Six District
 West of the ancient Boundary Line
 Pursuant to a warrant from John Thomas Esq.
 Commissioner of Locations Dated the 20th
 day of January 1785, I have admeasured
 and laid out unto Samuel Pile a tract
 of Land containing six hundred & forty
 acres, lying on both sides of Meely River
 including the Mouth of Stoney Creek, bounded
 N.W. by James Sefly's Land, all other sides by
 Vacant Land, and hath such shape and Marks
 as the annexed Plat Represents
 Survey, the 3rd day of January 1785,
 Recorded 5th May 1785, by Andrew Thomson Ds.

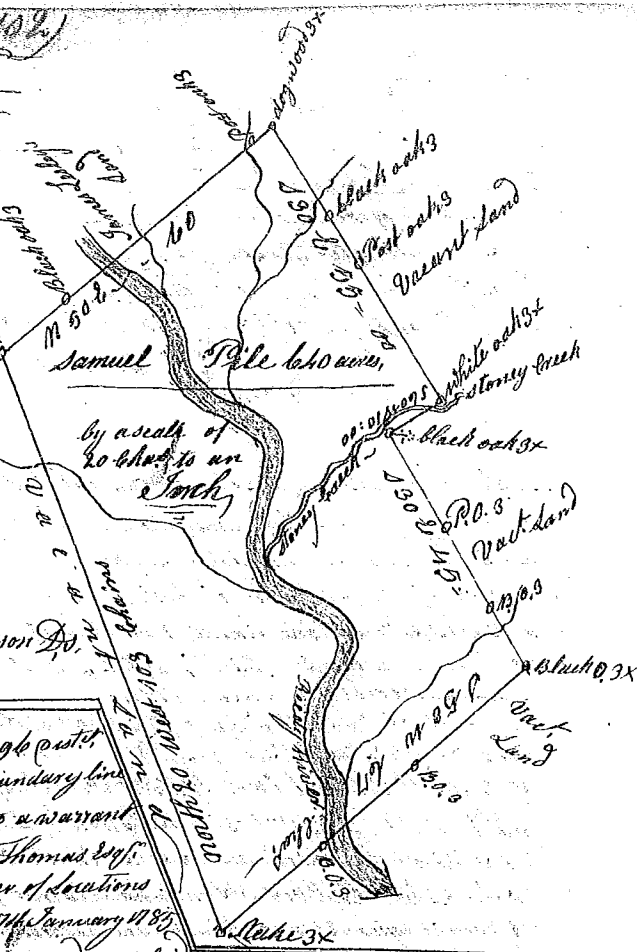

State of South Carolina 96 District
 East of the ancient Boundary Line
 Pursuant to a warrant
 from John Thomas Esq.
 Commissioner of Locations
 dated the 20th January 1785
 I have admeasured and laid
 out unto Isaac Wofford a tract of Land containing 107 acres
 situate lying and being on both sides of Mullawayns creek
 a branch of Fair forest, bounded N. by James Sefly's Land W. by
 by Ralph Smith Esq's Land, S. by John Wofford's Land, all
 other sides Vacant Land, and hath such shape and Marks as
 the above Plat Represents, Survey, the 23rd January 1785,
 Recorded 5th May 1785, by Andrew Thomson Ds.

State of South Carolina,
 Pursuant to a warrant from John Thomas Esq. Commissioner
 of Locations, I have admeasured and laid out unto Samuel
 M'junkin a tract of two hundred and twenty ^{acres} of Land,
 situate in ninety six District on branches of Browns Creek
 and hath such shape, Marks, Cuttings and Boundings
 as the annexed Plat Represents, Survey, the 4th April 1785,
 Recorded the 5th May 1785, by Ber. Glenn Ds.

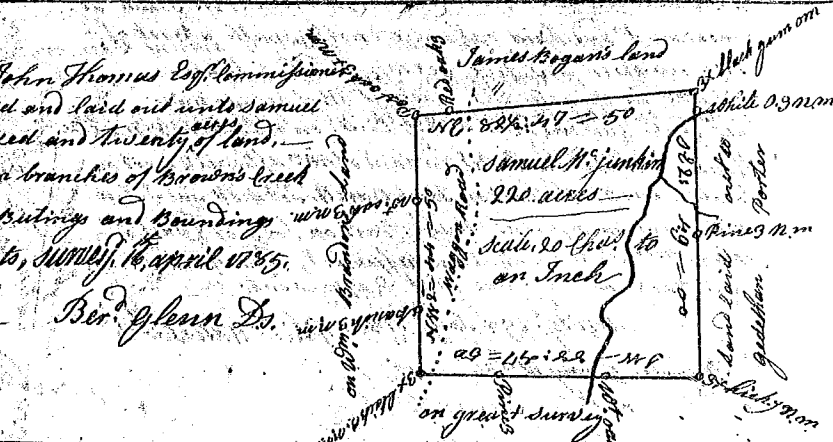

State of South Carolina,
 Pursuant to a warrant from John Thomas Esq. Com-
 missioner of Locations, I have admeasured and laid
 out unto Sean M'junkin a tract of forty acres of Land
 situate in Ninety Six District on Timber Creek a branch
 of Sagger River, and hath such Cuttings, Boundings
 shape and Marks as the above Plat Represents,
 Survey, 10th day of April 1785, by Ber. Glenn Ds.
 Recorded 5th May 1785,

