(116)

State of So Carolina 96 district East of the old Boundary line,
Pursuant to a warrant from John Thomas Esqr.
Commissioner of Locations dated 15 January 1785.
I have admeasured and Laid out unto John
Smith a tract of Land Containing one hundred
and forty three acres, lying on the south side
of fairforest, on a small branch of said Creek
Call'd the Marked Beech branch, Bounded N.E. by
P. John Smiths Land, W. by Richd. Hamptons Land
S.W. by Fredrick Lisons Land, and Hath such
Shape and Marks as the above plat Represents, Survey'd the 10th March 1785. by And.w Thomson D.S.
Recorded the 14th May 1785.

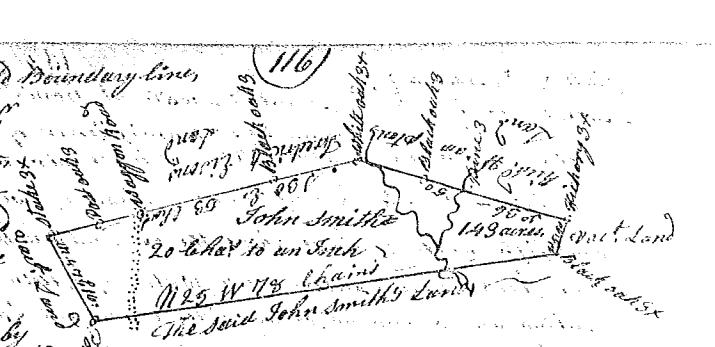

State of So Carolina 96 district East of the old Boundary line.
Pursuant to a warrant from John Thomas Esqr. Commissioner
of Locations dated the 25th day of Jany. 1785, I have
admeasured and Laid out unto Elkanah Hutchison
a tract of Land Containing Three Hundred and Two
acres, situate Lying and being on a branch of Tygar River
called Reisdatts Branch, and Hath such shape and
Marks as the above plat Represents
Survey'd the 10th day of march 1785.
by Andrew Thomson D.S.
Recorded the 14th May 1785.

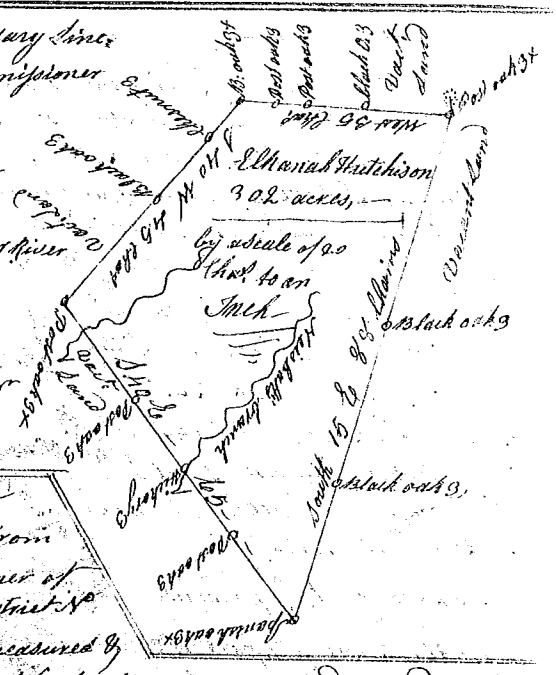

State of South Carolina,
Pursuant to a warrant from
John Thomas Commissioner of
Locations in Ninety six district No
Saluda River, I have admeasured &
Laid out unto Thomas Ward a tract of one Hundred and fifty acres
of Land on the Branches of Duncans Creek below the Indian Boundary
Bounding S.E. & N.E. on Land laid out to Mary Brown, S.E. & S.W. on
James M.Loughlins land & vacant Land N.W. & S.W. on Robt. Hutchinson
Land N.W. on Vacant Land, and Hath such shape and Marks as
the above plat Represents, Survey'd 28 march 1785.
by Robert Hanna D.S.
Recorded the 18th May 1785.

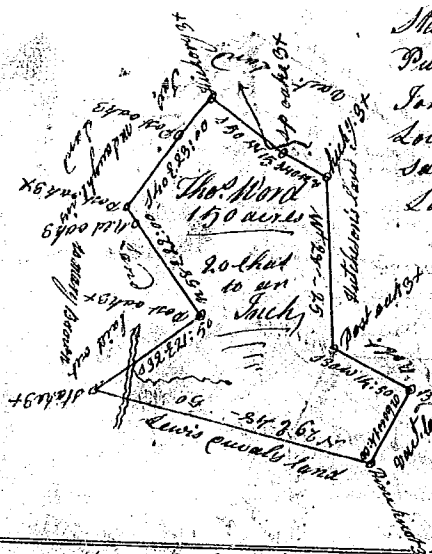
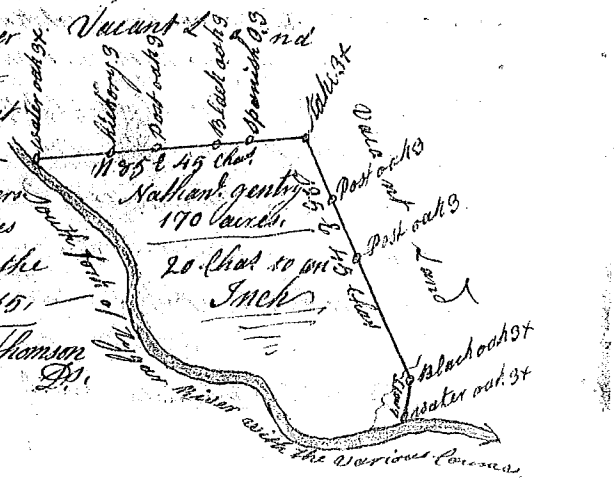
State of South Carolina 96 district East of the old Boundary line.
Pursuant to a warrant from John Thomas Esqr. Commissioner
of Locations dated the 29th day of February 1785, I have ad-
measured and laid out unto Nathaniel gentry a tract
of Land Containing one hundred and Seventy acres
Situate between the North & South fork of Tygar River
Bounded S.W.ly by the S.th fork of Tygar River, all sides
Vacant Land, and Hath such shape and Marks as the
above Plat Represents, Survey'd the 28th Feb.y 1785.
Recorded 14th May 1785.
by Andrew Thomson D.S.