(215)

State of South Carolina Pursuant to a Warrant from John Thomas Esq. Ch. in 96 District No. Lands on Thave admeasured & laid out Unto Capt. John McCool a tract of 406 Acres of Land Situate in 96 District Union County on the Waters of Fairforest & Browns Creek. Bounding WNW on a great Survey Unknown NE on Wm Kings land SE on John Cunninghams Land SW on John Dobsons land SW on Gabriel Andersons Land NW. on Land laid out to Walter Holmes the place now appointed for Court house, & hath such Stake & marks as the Annexed Plat Represents

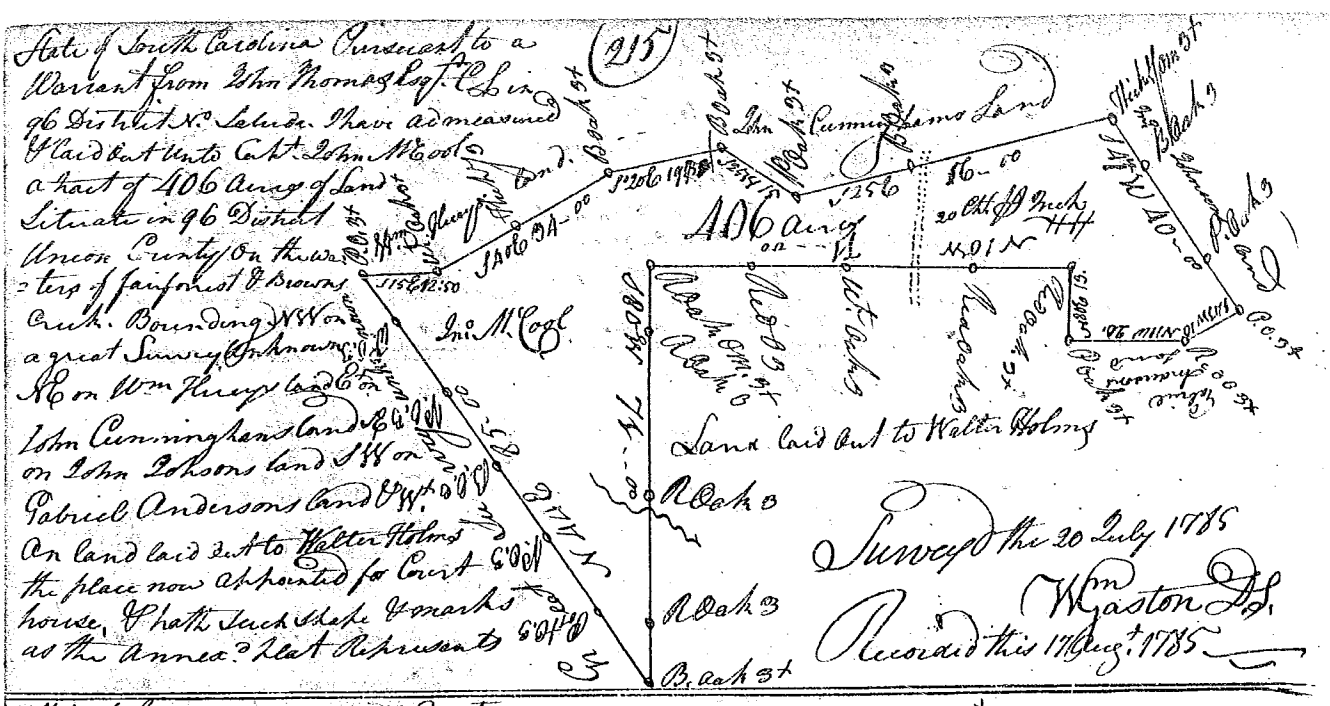

State of South Carolina Union County Pursuant to a Warrant from John Thomas Esqr Comd. in 96 District No. on Catawba River I have admeasured & laid out Unto Capt. Fore a tract of 640 Acres of Land situate in 96 Dist. On the Land of Buffalo Creek a Branch of Fairforest Bounded No. on Col. Woodards Land W. on Mrs. McDougals Land So. On Evan Thomas & Camerons Hays Land E. On Hughes Land all other sides Vacant Land with such Stake & marks as the above Plat Represents Survey'd the 25 August 1785 Recorded this 29th Augt. 1785

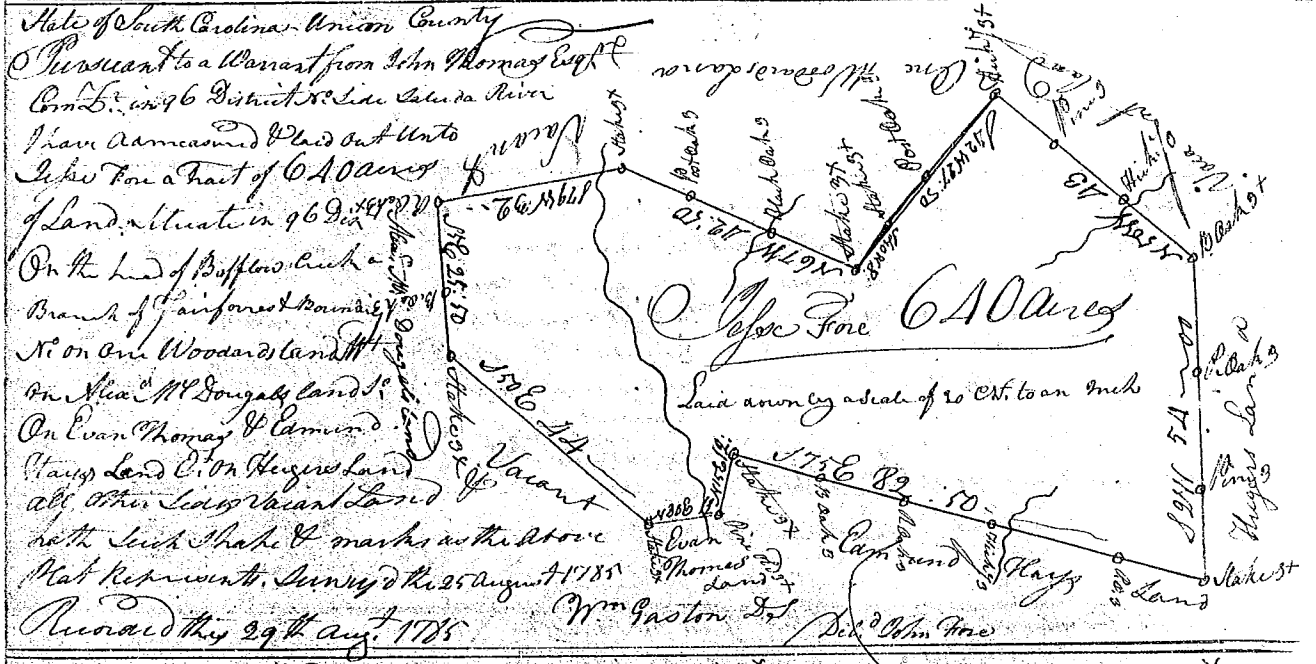

State of N. Carolina Union County Pursuant to a warrant from John Thomas Esq. Ch. in 96 District No. Lies Catawba I have admeasured & laid Out Unto Urias Faulk a tract of 500 Acres of Land Situate in 96 District on the Waters of Fairforest Bounded SW & SE on Great Surveys Unknown NW on John Bogan NW on Ed. Howard all other sides Vacant & hath such Stake & marks as the above Plat Represents Survey'd the 22 July 1785 Recorded this 29 Augt. 1785 Wm Gaston D.S.
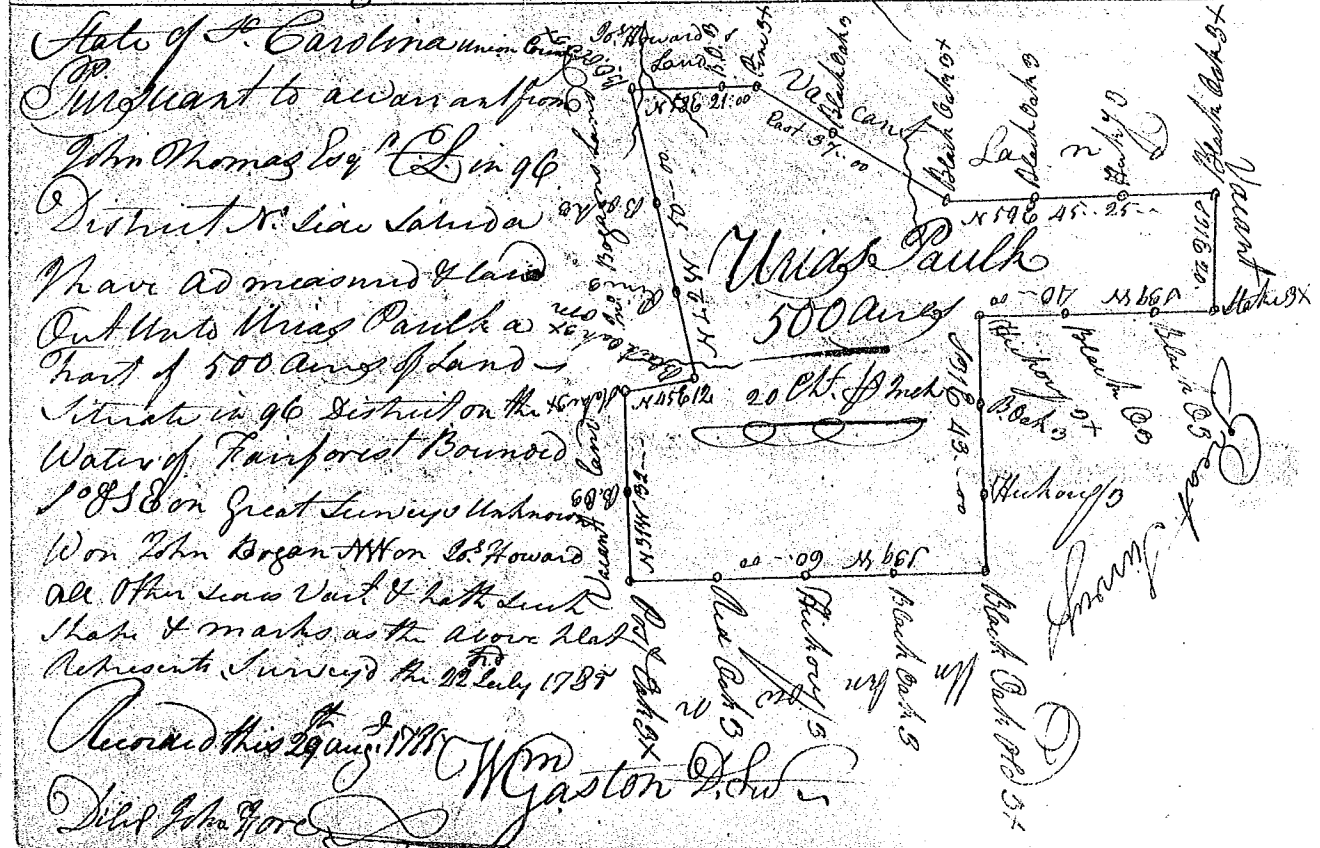
Dilt. Chas Fore