

State of S^c Carolina,

Pursuant to a warrant from John Thomas Esq^r. Dated the 6th June 1785, I have admeasured and laid out unto John Keagon a tract of one hundred and thirty seven acres of land, situate in 96th District, on waters of Bush River, and hath such shape, Marks, — buildings and boundings as the above Plat represents, SURVEY^d 20 June 1785, Phil^l Waters Esq^r Recorded 14 Oct^r 1785.



State of S^c Carolina,


Pursuant to a warrant from John Thomas Esq^r. Commissioner of 96th District of Saluda river, dated 16th June 1785, I have admeasured and laid out unto John Keagon a tract of one hundred and fourteen acres of land situate in 96th District N^o of Saluda river, below the ancient boundary, on waters of Saluda river, bounded N^o by Coates's land, S^o by James Galaway's land, and vac^d land on all other sides by vac^d land, and hath such shape & Marks as the above Plat represents, SURVEY^d 10 Sept^r 1785, Recorded 14 Oct^r 1785, Phil^l Waters Esq^r.

State of South Carolina,

Pursuant to a warrant from John Thomas Esq^r dated the 16th June 1785, I have admeasured and laid out unto John Keagon a tract of one hundred and ten acres of land situate in 96th District on the N^o of Saluda river, and hath such shape, Marks, buildings and boundings as the above Plat represents, SURVEY^d 11th Aug^t 1785, Recorded 14th Oct^r 1785, Phil^l Waters Esq^r.

State of S^c Carolina,

Pursuant to a warrant from John Thomas Esq^r Commissioner of locations, I have admeasured and laid out unto John Adlington a tract of 277 acres of land situate in Union & 96th District below the ancient limits on a small branch running into Enoree River, and hath such shape, Marks, buildings and boundings as the above Plat represents, SURVEY^d 24 Aug^t 1785, Recorded 15 Oct^r 1785, Abel Pearson Esq^r Phil^l Waters Esq^r.

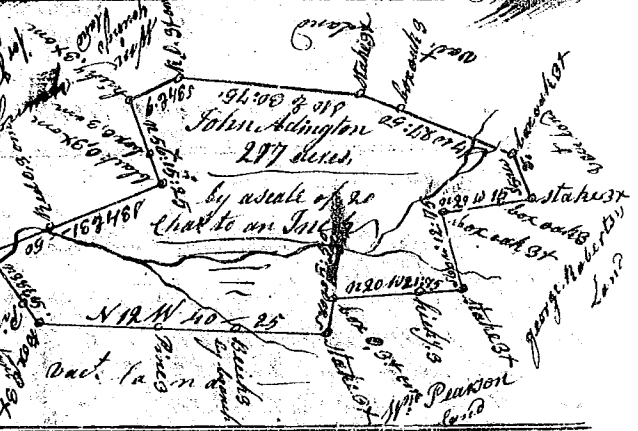

State of S^c Carolina,

Pursuant to a warrant from John Thomas Esq^r Commissioner of locations, dated I have admeasured and laid out unto James Adlington a tract of 535 acres of land situate in Union County, Ninety six District below the ancient limits on the S^o Side of Tugar river, and hath such shape, Marks & buildings and boundings as the above Plat represents, SURVEY^d 21st Aug^t 1785, Abel Pearson Esq^r Recorded 15th Oct^r 1785, Phil^l Waters Esq^r.

