



State of S^c Carolina Pursuant to a warrant from John Thomas Esq. Com^r of Locations Dated the 1st of ~~the~~ 1785 I have admeasured & laid out unto ~~Charles Benson~~ ^{Charles Benson} a tract of one hundred & thirty seven acres of land situated in District No. 1 above the old boundary on the North side of the Saluda River the middle below Watauga's Plain & that such shape & marks & buttings & boundaries as the above Plat represents to survey the 21st of Oct. 1785. Recorded the 24th of Oct. 1785. I, ^{Wm. Whitmer} Delivered to ^{Charles Benson}

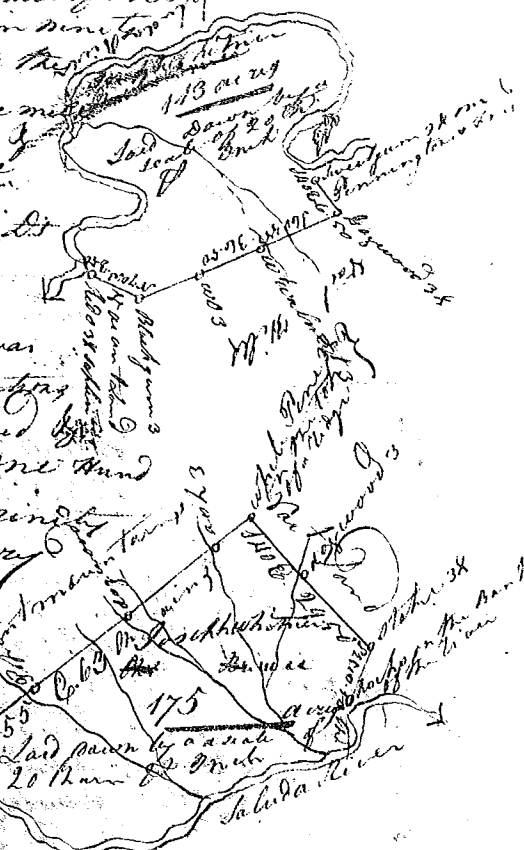

State of S^c Carolina Pursuant to a warrant from John Thomas Esq. Com^r of Locations Dated the 19th of Oct. 1785 I have admeasured & laid out unto ~~Charles Benson~~ ^{Charles Benson} a tract of one hundred & seventy five acres of land situated in District No. 1 above the old boundary on the North side of the Saluda River near the Table Mountain all sides on the west Land & that such shape & marks as the above Plat represents to survey the 25th of Oct. 1785. Recorded the 24th of Oct. 1785. I, ^{Wm. Whitmer} Delivered to ^{Charles Benson}

State of S^c Carolina Pursuant to a warrant from John Thomas Esq. Com^r of Locations Dated the 18th August 1785 I have admeasured & laid out unto William Benson a tract of land containing two hundred & twenty two acres in 96 distinct East of the Ancient Boundary on the Pinestone Branch of Fairforest Creek of that such shape and marks as the annexed plat represents. Surveyed this 19th Aug. 1785. Recorded 25th Oct. 1785. I, ^{Wm. Whitmer} to ^{Wm. Benson}

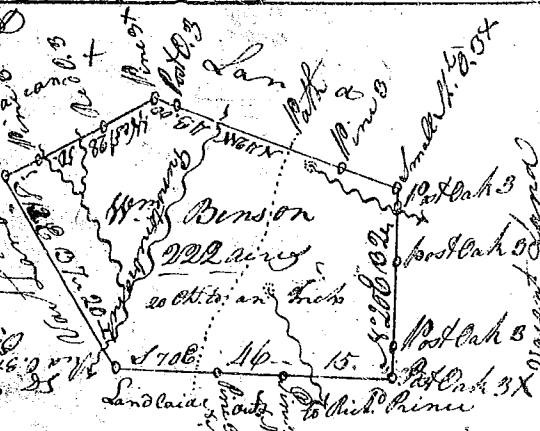

State of S^c Carolina Pursuant to a warrant from John Thomas Esq. Com^r of Locations Dated the 25th Oct. 1785 I have admeasured and laid out unto ~~any~~ ^{William M. Williams} a tract of land containing two hundred and thirty seven acres lying in District No. 1 on both sides of the Fork of Durbin's Creek, and that such shape, marks, buttings and boundaries as the above Plat represents. Surveyed 27th Oct. 1785. I, ^{Wm. Whitmer} to ^{William M. Williams}

