



State of South Carolina 96 District East of the old boundary,
 Pursuant to a warrant from John Thomas Esq. Commissioner of locations Dated the 26 Sept. 1785,
 I have admeasured and laid out unto John Moorhead a tract of land
 containing six hundred and thirty four acres, situate
 lying and being between Broad and Pacolote Rivers
 on Malcoms Creek, and Gallegys Creek waters of Pacolote River
 and hath such buttings and boundings, and Marks as the
 above Plat Represents,
 Survey. 8th Oct. 1785.

Recorded 17 Nov. 1785, And^{rs} Thomson D.

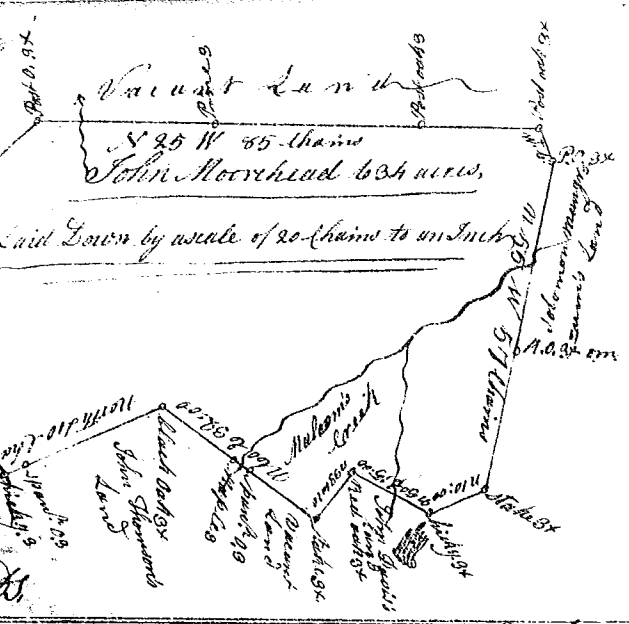

State of South Carolina Pursuant to a warrant from John Thomas Esq. 96 District East of the boundary line
 Commissioner of locations Dated 24th Oct. 1785, I have admeasured and laid out unto Edmond Ellis a tract of land containing one
 hundred and one acre, lying between Pacolote and broad Rivers,
 bounded to the N.W. by George Marchbanks land, all other sides
 Vacant Land, and hath such shape, and Marks as the above Plat
 Represents, Survey. 31 Oct. 1785. And^{rs} Thomson D.

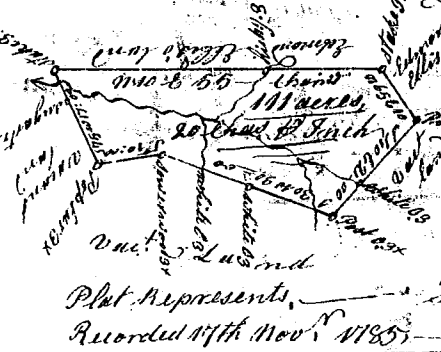

State of South Carolina 96 District East of the ancient boundaries
 Pursuant to a warrant from John Thomas Esq. Commissioner of locations Dated 24th Oct. 1785
 I have admeasured and laid out unto Edmond Ellis a tract
 of land containing one hundred and eleven acres situated
 between Broad & Pacolote Rivers on both sides of Ford branch,
 bounded N.W. by the said Edmond Ellis's land, all other sides
 by vacant land, and hath such shape, and Marks as the above
 Plat Represents, Survey. 31st day of Oct. 1785, by Andrew Thomson D.

State of South Carolina,
 Pursuant to a warrant from John Thomas Esq. Commissioner
 of locations, I have admeasured and laid out unto William
 Cooper a tract 109 acres of land, situate in Union County
 96 District below the ancient limits, on two small branches
 of Tygar River, and hath such shape, marks, buttings
 and boundings as the above Plat Represents, Survey. 11 Nov.
 1785, Recorded 19th Nov. 1785 Del. Lawrence Pearson



State of South Carolina,
 Pursuant to a warrant from John Thomas Esq. Comm.
 of locations in ninety six District N. of Saluda, I have
 admeasured and laid out unto Lawrence Pearson a tract
 of one hundred acres of land, situate in ninety six District
 on the waters of Snowe River, bounding N.W. on John Townsends
 land, S.W. on John Pearson's land, all other sides on vacant
 land, and hath such shape and marks, as the above Plat
 Represents, Survey. 18 June 1785, Wm. Taffton D.
 Recorded 19th Nov. 1785 Del. Amclett

