


State of South Carolina
 Pursuant to a warrant from John Thomas Esq.
 Commissioner of Locations Dated 30th Decr 1795
 I have admeasured and laid out unto James
 Miller a tract of land containing three hundred
 and eighty five acres, in Spartanburg
 County, between the south & Middle fork of
 Sugar rivers, bounded S.W. by said S^r Barry's
 Miller's land, all other sides by vacant
 land, and hath such shape and marks as
 the above Plat represents, Survey 6th Jan^y 1796
 Recorded 25th Jan^y 1796, — Andrew Thomson Esq.




State of South Carolina,
 Pursuant to a warrant from John Thomas Esq.
 Commissioner of Locations Dated the 30th Decr 1795,
 I have admeasured and laid out unto James Miller
 a tract of one hundred and seventy acres of land
 in Spartanburg County, on the south side of the middle
 fork of Sugar River, bounded N. E. by S^r J. Miller's
 land, S.W. by S^r Alexander's land, W. by John Barry's
 land, all other sides by vacant land, and hath such shape
 and marks as the above Plat represents, Survey 6th Jan^y 1796
 Recorded 25th Jan^y 1796, — Andrew Thomson Esq.

State of Carolina 96 District N^o of Saluda east of
 the old Boundary line Pursuant to a warrant
 from John Thomas Esq. C^o Dated the 20th Nov^r
 1795. I have admeasured & laid out unto
 Holloway Power a Tract of 250 acres of land
 Situate lying & being on a branch of Distins
 Creek waters of Enore River. & Bound S.W.
 by Samuel Cobbs land N. E. by M^r G^oshens land South
 by John Howards land all other sides vacant
 hath such shape & marks as the above plat
 represents Surveyed this 30th Nov^r 1795 by James W. Ford Esq.
 Recorded this 26th Jan^y 1796 — D^r John Brown

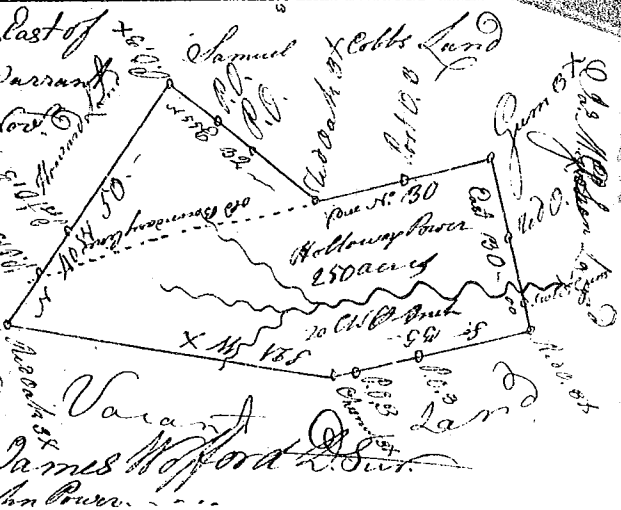

State of S^c Carolina Pursuant to a
 Warrant from John Thomas Esq.
 C^o I have admeasured & laid
 out unto George Newton a tract
 of 518 acres of land
 Situate on the district on
 the waters of Browny Creek
 of the waters of the S^c Side of
 Broad River hath such shape
 marks, Bettleing of bounding as the
 above plat represents Surveyed 28th Nov^r 1796
 Recorded 26th
 Jan^y 1796

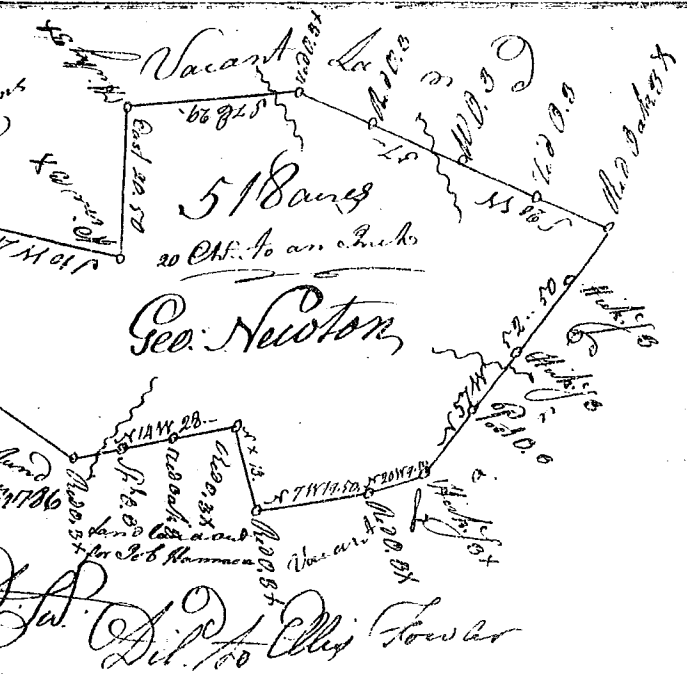

Recorded 26th
 Jan^y 1796

Charles Sims Esq. D^r J. P. Ellis Town