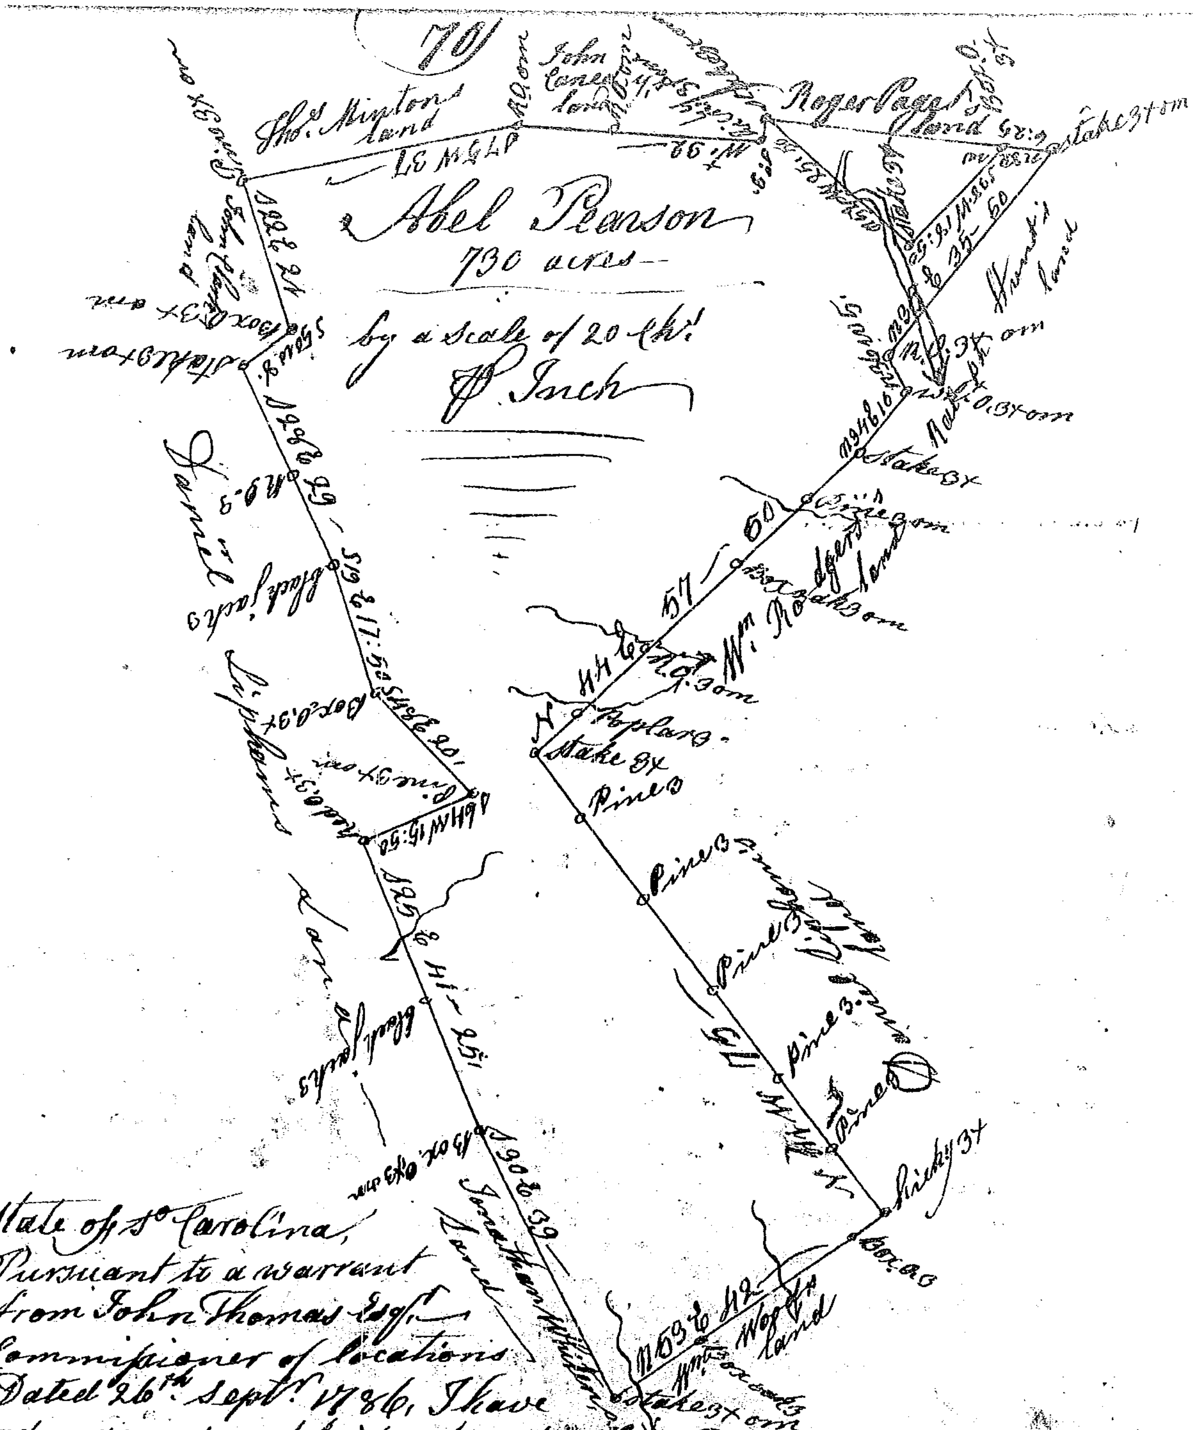

State of So Carolina,
Pursuant to a warrant
from John Thomas Esq.
Commissioner of Locations
Dated 26th Septr 1786, I have
admeasured and laid out unto Abel Pearson a tract of seven
hundred and thirty acres of land, in Ninety Six District in
Union County, on the waters of Tygar & Enoree Rivers, and
hath such Shape, marks, butting & boundings as the above Plat
Represents,

Survey'd 26th Septr 1786

Recorded 27th Septr 1786,

Abel Pearson D.S.