


State of South Carolina

Pursuant to a warrant from John Thomas Esq. Comr. of locations & c. I have surveyed and laid out unto Granger Camp, a tract of four hundred & thirty five acres of land in 96 District on the Waters of Horse Creek a branch of broad river, bounded N. by North Carolina, & S. by lands the names unknown, E. & W. by vacant lands, and hath such shape, form & Marks as the above Plat represents

Surveyed 18th May 1786
 Recorded 21st May 1786
 Det. self
 P. Dardree M. Beechey

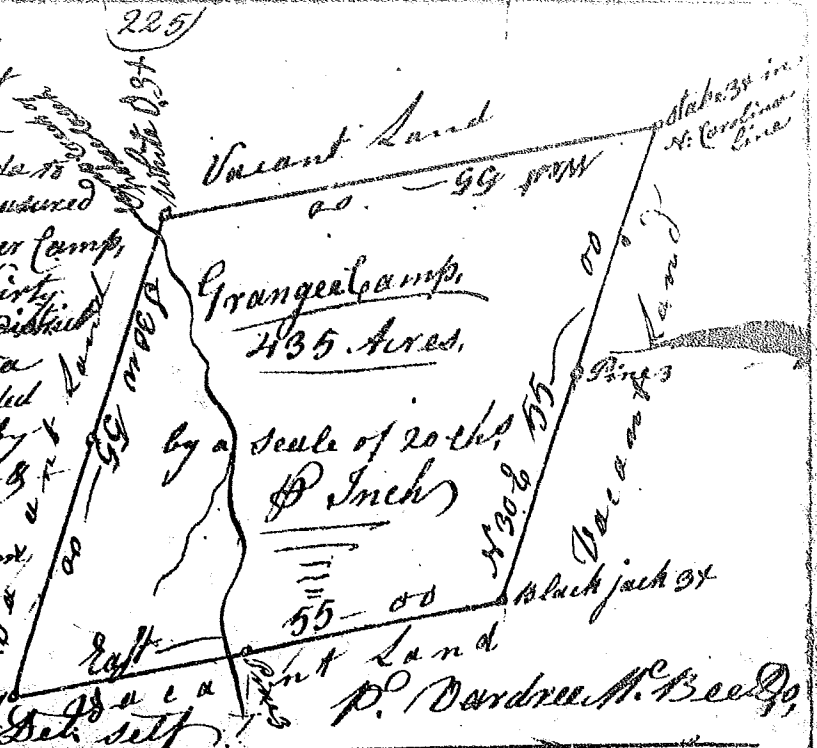

State of S Carolina

Pursuant to a warrant from John Thomas Esq. Comr. of locations Dated 2nd March 1787 I have surveyed and laid out unto William Pool a tract of 2712 acres of land in ninety six District Spartanburg County on the branches of Sawson's fork & fair forest bounded N. by Goodley's & Bushoff's lands, S. E. by Jeremiah Walker & James Steadman's lands, N. E. by Wood's land and other lines by Vac. or lands unknown, and hath such shape, Marks, buttings & boundings as the above Plat represents,

120

Surveyed 4th March 1787
 Recorded 28th May 1787
 Det. self
 J. J. Connell Esq.

