


State of South Carolina Pursuant to a warrant from John Thomas Esq. Comr. of locations, I have admeasured & laid out unto Abraham Markley a tract of one thousand acres of land, in 96 District on the S<sup>o</sup> side of Pacolat river bounded N<sup>o</sup> by John Moore's land, W<sup>o</sup> by Abraham Markley's land, S<sup>o</sup> by land unknown, E<sup>o</sup> by land unknown, and hath such shape form & Marks as the above Plat represents.

Survey 6<sup>th</sup> May 1788,  
Recorded 11<sup>th</sup> June 1788.

Vardry M. Bee Esq.

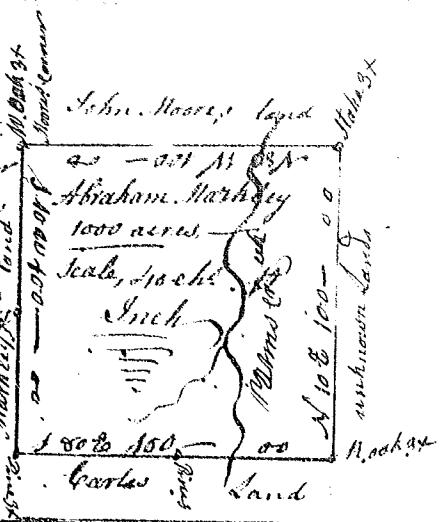

State of S<sup>o</sup> Carolina, Pursuant to a warrant from John Thomas Esq. Comr. of loc<sup>o</sup> I have admeasured & laid out unto Abraham Markley a tract of one thousand acres of land in 96 District on the S<sup>o</sup> side of Pacolat river, bounded E<sup>o</sup> by John Moore's land, S<sup>o</sup> & W<sup>o</sup> by land the owners not known, N<sup>o</sup> by James Hoopers land, and hath such shape form & Marks as the above Plat represents, Survey 8<sup>th</sup> May 1788.


Recorded 11<sup>th</sup> June 1788.

Vardry M. Bee Esq.

State of S<sup>o</sup> Carolina Pursuant to a warrant from John Thomas Esq. Comr. of loc<sup>o</sup> I have admeasured and laid out unto Abraham Markley a tract of one thousand acres of land on the N<sup>o</sup> side of Pacolat river, bounded W<sup>o</sup> by lands laid out for said Markley & Pacolat river, S<sup>o</sup> by Low's land, E<sup>o</sup> & N<sup>o</sup> by vacant land and hath such shape form & Marks as the above Plat represents.

Survey 15<sup>th</sup> May 1788  
Recorded 11<sup>th</sup> June 1788.

Vardry M. Bee Esq.

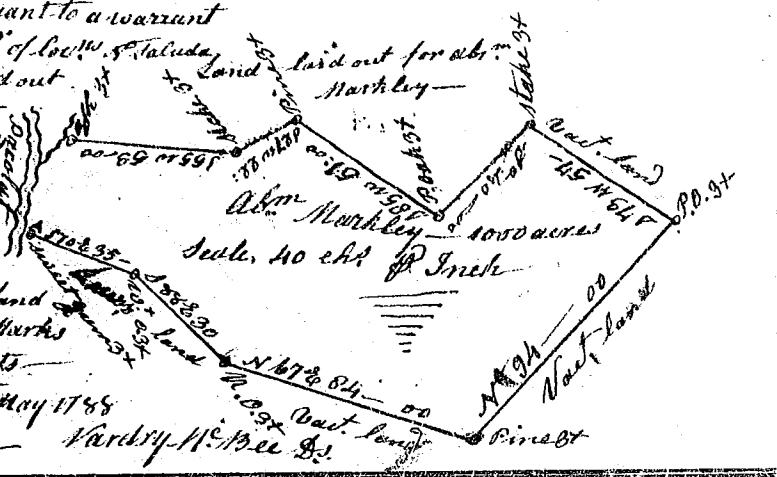

State of S<sup>o</sup> Carolina, Pursuant to a warrant from John Thomas Esq. Comr. of locations N<sup>o</sup> Saluda, I have admeasured & laid out unto Abraham Markley a tract of one thousand acres of land on the ridge between Island Creek & the head of Stickly, bounded E<sup>o</sup> on Brown's land N<sup>o</sup> by Hopkins, W<sup>o</sup> W<sup>o</sup> by Doct. O. Wright's land, S<sup>o</sup> by land laid out to abm. Markley, and hath such marks shape and shape as the above Plat represents, Survey 11<sup>th</sup> May 1788.

Recorded 11<sup>th</sup> June 1788.

Vardry M. Bee Esq.

