(24)

State of So Carolina, Pursuant to a warrant from John Thomas Esqr Comr of locations No Saluda I have admeasured and laid out unto William Crocher a tract of four hundred & fifteen acres of land on the Branches of Pacolat call'd Richland Creek, bounded &c by land laid out by the Publick for the use of the Ironworks, S & W. by William Crochers old land, E. by William Jemsons land, and hath such shape form and Marks as the above Plat Represents, Survey'd 14th April 1788. Varnby M. Bee D.S.
Recorded 18th June 1788. —

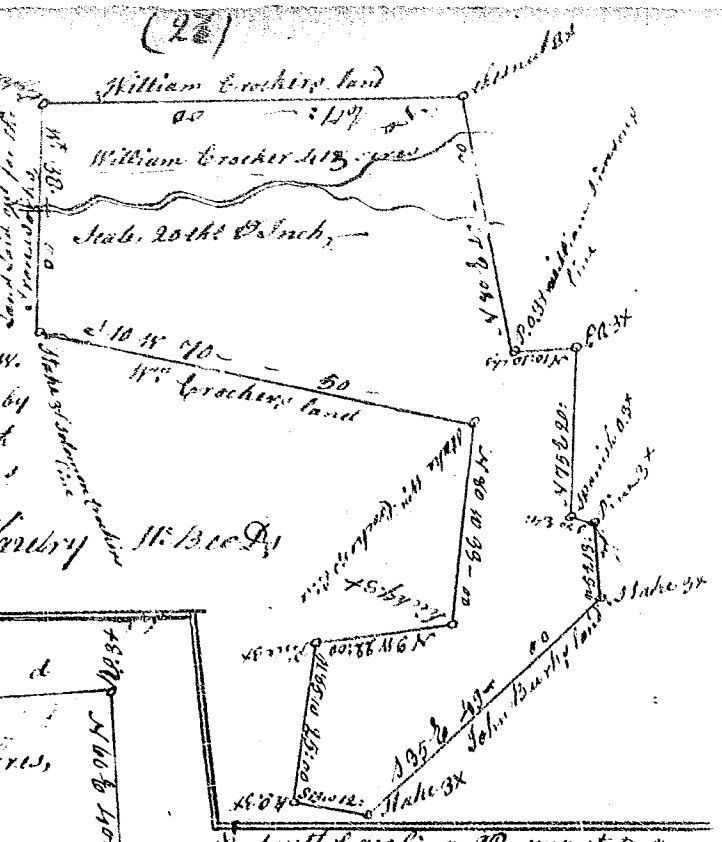

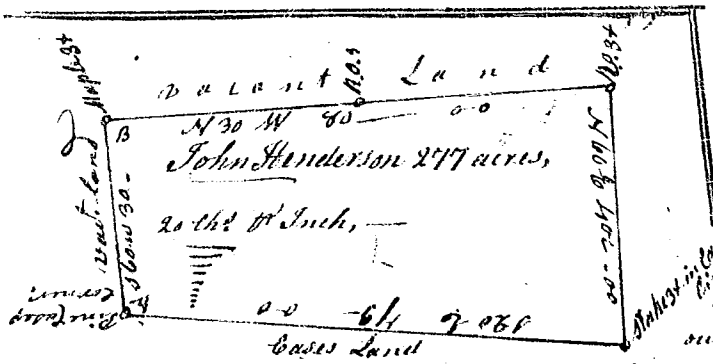

South Carolina, Pursuant to a warrant from John Thomas Esqr Comr of locations No Saluda, I have admeasured and laid out unto John Henderson a tract of Two hundred & Seventy Seven acres of land in 96 District & Waters of Buck Creek Bounded N.E. by Casey's land, all other sides Vacant land, and hath such Shape form and Marks as the above Plat Represents, Survey'd 13th May 1788.
Recorded 18th June 1788.
Varnby M. Bee D.S.
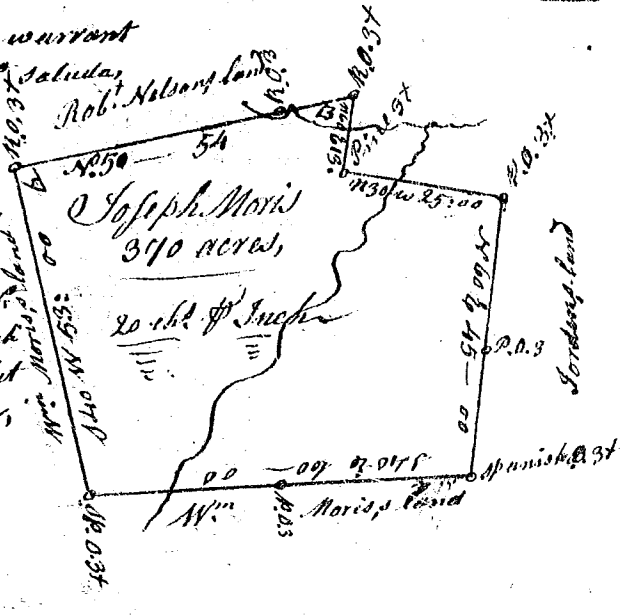
State of So Carolina, Pursuant to a warrant from John Thomas Comr of Locations No Saluda, I have admeasured and laid out unto Joseph Morris a tract of Three hundred & Seventy acres of land in 96 District, Bounded N by Jordins land, E & S by Morris's land, W by Robt Nelsons land, Lying on Buck Creek N side of Pacolat River, Having such Shape form & Marks as the above Plat Represents, Survey'd 14th May 1788.
Varnby M. Bee D.S.
Recorded 18th June 1788. —