

North Carolina Pursuant to a (93)

warrant from John Thomas Esq. Commissioner of Locations Dated 26th Oct. 1789, I have admeasured & laid out unto Samuel Forbert a tract of 90 acres of land in the District on the West Side of Broad River bounding by a line running S. 8. by land survey for Samuel Forbert, by a line running N. 8. W. by land survey for Joseph Pollock, by a line running S. 8. & N. W. by land survey for J. Williams, and the other side on Broad River, and hath such form and marks as the above Plat represents, Survey 29th Oct. 1789. J. Gaston Esq.


Recorded 12. 40th 1789. Del. Self



State of N. Carolina Pursuant to a warrant from John Thomas Esq. Commissioner of Locations Dated 22nd Sept. 1789, I have admeasured and laid out unto Joseph Lively a tract of two hundred & thirty eight acres of land, in the District of Spartanburg County on Lindsly's Creek a branch of Pacolet River, bounded S. by William Wofford, Joseph Lively, Jeremiah Walker, on the N. & by Col. Henderson on the E. and hath such and boundings as the above Plat represents, Certified for the 27th Sept. 1789. Recorded the 13th Nov. 1789. Del. Michael Haddock.



South Carolina Pursuant to a warrant from John Thomas Esq. Comr. of locations in the 9th District, N. Saluda, Dated 12th Oct. 1789, I have admeasured and laid out unto John Goswin a tract of 215 acres of land, in Mill Creek & branches of South Pacolet river, bounded by a line running S. E. & N. granted to John McClean, and by a line running W. & N. granted to John Goswin, and hath such form and marks as the above Plat represents, Survey 24th July 1789. Recorded 13th Nov. 1789, Del. son

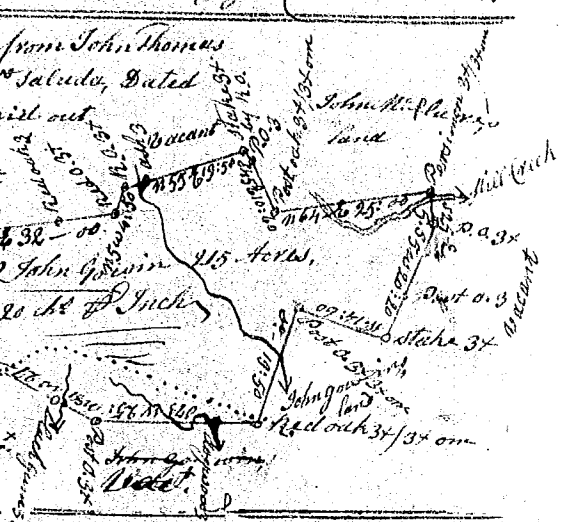

N. Carolina 9th Dist. E. of the ancient boundary line, Pursuant to a warrant from John Thomas Esq. Comr. of Loc. dated 15th Dec. 1789 I have admeasured & laid out unto James M. Cleary a tract of one hundred and twenty one acres of land, on the small Branches of Mc Clearys Creek a branch of Pineforest Creek bounded N. E. by Arthur Fosters land, S. E. by Alex. McCurters land, S. by vacant land, N. W. by said James M. Clearys land, and hath such shape and marks as the above Plat represents, Survey 3rd Juny 1785.

Recorded 27th November 1789. And. Thomson Esq.

