



South Carolina Pursuant to a warrant from John Thomas Esq. Commissioner of locations Dated 13th April 1799
 I have admeasured and laid out unto Solomon Niblet a tract of 406 acres of land in Laurens County, on the waters of Beaverdam and Warriors creek bounded N. by William Hanleys land, W. on Dunclops Dunclops Sr. on land laid out unknown, and hath such shape, marks & boundaries as the above Plat represents,
 Recorded 27th June 1799. Del. self Survey 13th April 1799. South: Downs Jr.

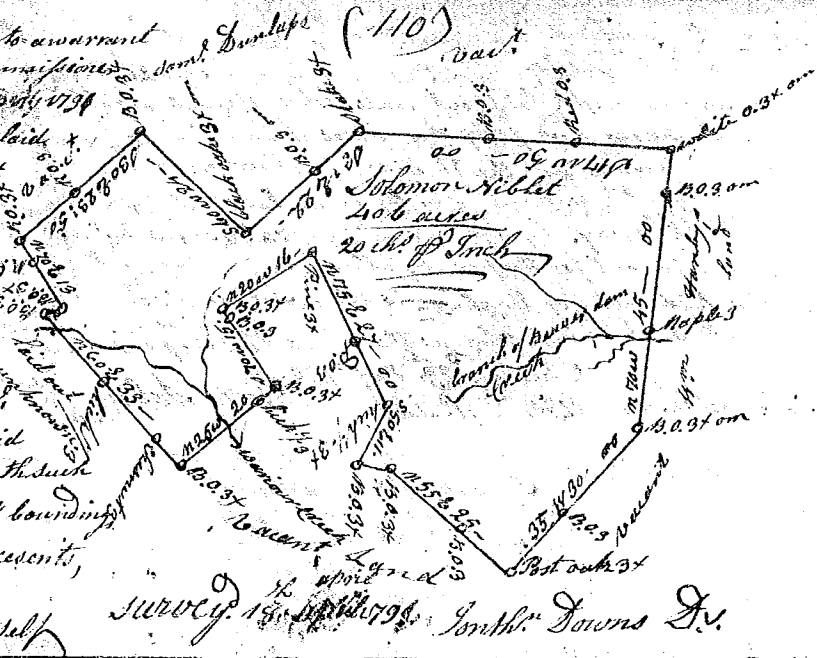

South Carolina Pursuant to a warrant from John Thomas Esq. Commissioner of locations Dated 29th May 1790
 I have admeasured and laid out unto James Young a tract of 442 acres of land in said District on the North fork of Bush river, bounding N. on Tal Saxon & on Lewis Jones & John Hunter & Robt. M. Hair, W. on Andrew Anderson, and hath such shape, form and marks as the above Plat represents
 Survey 1st Augt 1790.
 Recorded 6th Augt 1790. Del. self John Rodgers D.

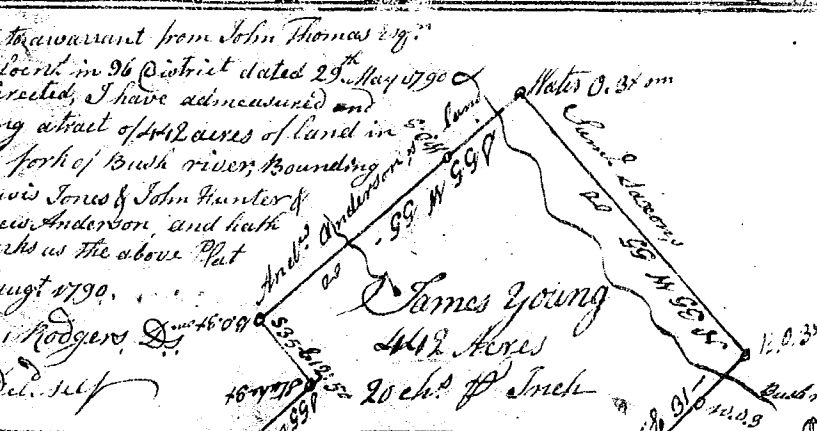

State of South Carolina Pursuant to a warrant from John Thomas Esq. Commissioner of locations, I have admeasured and laid out unto Erasmus Tolison a tract of 330 Acres of land in 4th District on the waters of Sugar river of Bushes run, and hath such form, marks, substance and boundaries as the above Plat represents
 Survey 1st Augt 1790.
 Recorded 30th Augt 1790.
 Del. father

