


South Carolina Pursuant to a warrant from
 John Thomas Esq. Comr. of loc^l for the Side of Saluda dated
 17th Jan^y 1791. I have admeasured and laid out
 unto Thomas McCrakin a tract of ninety five
 acres of land Situate in Newberry County 96 District
 on the hunting fork of Indian creek waters of
 Quora, bounded by a line running N 42 E 32 E
 by land surveyed for Thomas McCrakin and Agnes
 W. & N 50 E by one Hope & Agnes by Har. McCrakin
 S 3 E, 1400, S. 55 E by Nathaniel Gordon, N 37 E by
 Robert Willson. Now by W. Nimmens land
 and hath such shape and marks as the above Plat
 Represents, M^W 16th Jan^y 1791. A. Pearson
 Del. S. Murray.

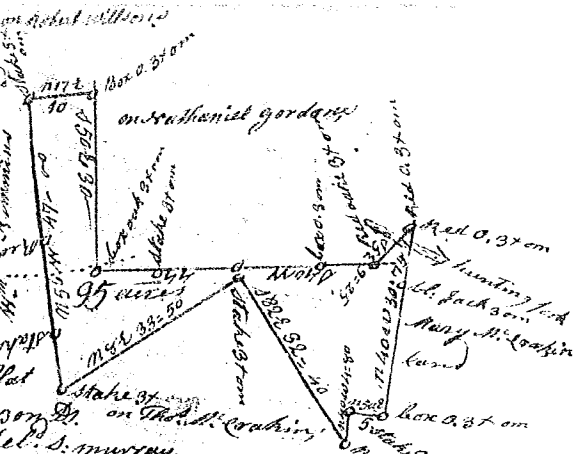

South Carolina Pursuant to a warrant from John Thomas Esq.
 Comr. of loc^l for the Side of Saluda (one directed bearing Date 7th Feb^y 1791.
 I have measured and laid out unto James Powell a tract of one thousand acres of land
 lying and being in 96 District and Greenville County and on the waters of
 and on Quilley Creek the waters of Quora river
 bounding N. by James Powell's land, N. 20 & E. by
 Kivels, Cofford's & Richardsons lands, S. E. S. E. & S. N. by
 waters and Wrights lands, westward by James
 Seaborn's land, and hath such a shape and marks as the annexed
 Plat Represents, Certified 25th Feb^y 1791. S. Murray
 James Harrison Esq.
 Recorded 18th April 1791, —
 Del. self.

