


State of S^c Carolina Pursuant to a warrant from John Thomas Esq. Com^r of Loc^y 96 I have admeasured and laid out unto Thomas Stribling a tract of 603 acres of land, in 96th District on sand branches of Sanderun, South side of Enoree River, which shape - form, marks, buttings & bounding, the annexed Plat will make appear
Survey, 16th May 1791

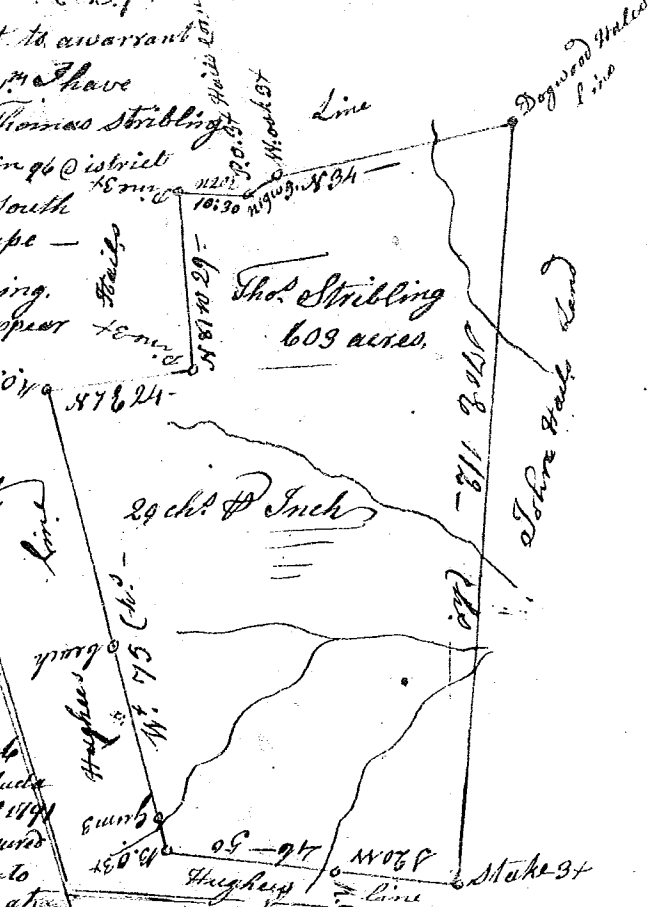


Charles Sims D^y,
Recorded 19th May 1791 - Del. self







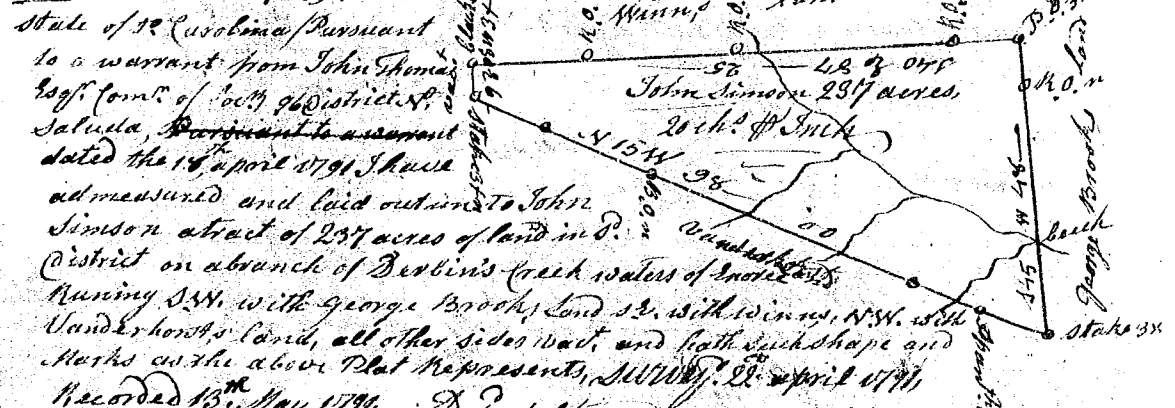

Recorded 16th May 1791, Del. self

State of S^c Carolina Pursuant to a warrant from John Thomas Esq. Com^r of Loc^y 96 District of Saluda dated 18th April 1791 I have admeasured and laid out unto John Simson a tract of 150 acres of land in said District on branches of Beaverdam Creek waters of Enoree River bounding S.E. Lightcap's Land S.W. & N.W. with Wolff's Land, all other sides vacant, and hath such shape form and marks as the above Plat represents

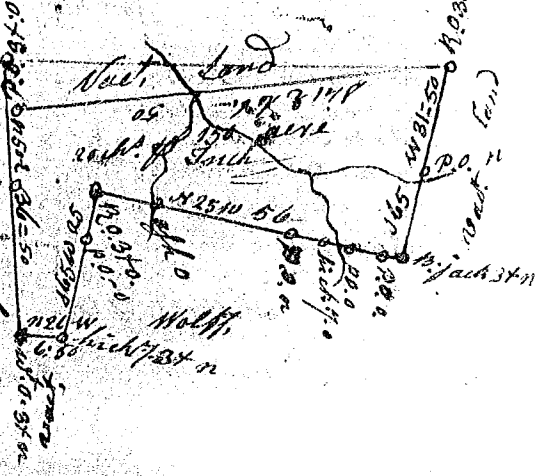

Survey, 25th April 1791

Recorded 16th May 1791 - Del. self

Del. self