State of S. Carolina / Pursuant to a warrant (213)
from John Thomas Esqr Court of vacations dated the 5th July 1786 I have admeasured and laid out unto Israel Gaunt a tract of thirty seven acres of land in Ninety Six District on waters of bush river & hath such shape, marks, buttings and boundings as the above Plat represents — Surveyd 25th augt 1786

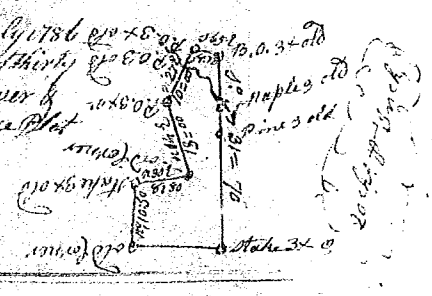

Recorded 10th octr 1792 / Dft John Ryley / Jas Wright D.S.

State of S. Carolina / Pursuant to a Warrant from
John Thomas Esqr Court of vacation in 96 District to me directed
dated 3d Septr 1792, I have admeasured and laid out
unto Jonas Redmon, a tract of one hundred
acres of land, in said District on Enoree Creek
of Saluda river in Greenville County Bounded
& Runs thus viz NW & NW by Henry Reinsland
SW by Eli Abernathys land, SE & South by Lunsford
Hudsons land, all other sides by vacant land
and hath such form & Marks as the above Plat
Represents. Surveyd 8th Septr 1792,

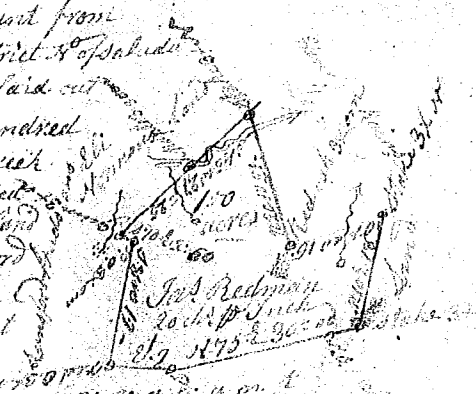

Recorded 18th octr 1792 / Dft A. Baker / By Wm D. Thomas D.S.

S. Carolina / Pursuant to a warrant from
John Thomas Esqr Court of vacation in 96
District No Saluda dated the 5th
Feb 1792 I have admeasured &
of land Situate in the District &
County & Province aforesaid on the
waters of Reedy River on Greenville
Creek Bounding to wit Beginning NW
by Cattle Brisons land NE 84 W
185 N 82 E 64 N 30 W by Isaac Greer
thence N & Bounds 76 by land laid
out for Richardson & Hall and Runs &
Bounds as the above Plat Represents

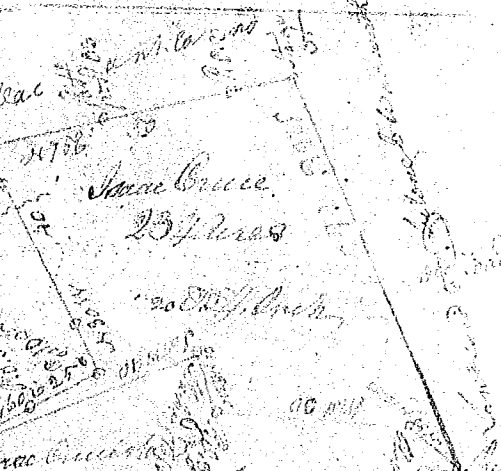

Surveyd 9th Feb 1792 Wm D. Thomas D.S.
Entered the 22nd Oct 1792 do D.S.

South Carolina — Pursuant to a warrant
from John Thomas Esqr Court of vacation
in Ninety Six District to me directed
dated the 8th day 1792, I have admeasured
& laid out unto John Walker a tract of Land
containing one hundred & fifty acres of land
in said District on Brushy Creek of Enoree River
Bounding to wit Beginning at a Pine
Corner of Isaac Greers Runs thence
Regularly Bounded by lines of Vacancy
NW by Jas McWilliams NE & NW & SW
NW by Moses Kemp & SE & Bounded
Regularly & Runs & Bounds as
marked on the above Plat Represents

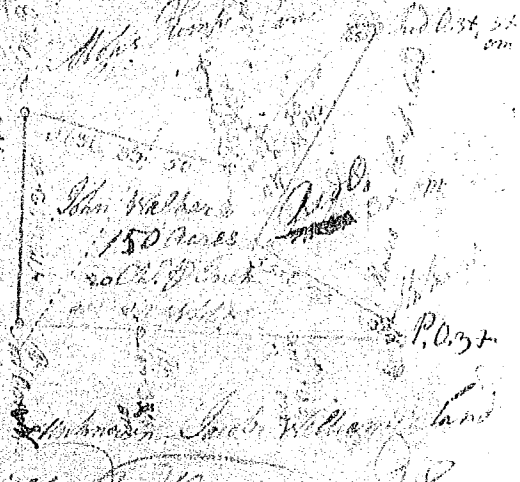

Surveyd 11th Sept 1792 Wm D. Thomas D.S.
Entered the 29th Oct 1792 do D.S.