


South Carolina Pursuant to a (234)
 warrant from John Thomas Esq. Commissioner of
 locations dated the 3rd January 1793. I have
 admeasured and laid out unto
 Sampson Bethel a tract of seven hundred
 = dreed and sixty one acres of land
 in Pinkney District Sparlandburg
 bounded by Jordanland
 N.W. Harris's land & by
 Medmons & Harris's lands
 all other sides by vacant
 land or Landowners
 and hath such shape
 Marks, boundaries
 and Boundings as
 the above Plat
 represents.

Survey'd the 4th Jan^y. 1793. Del^d. John Turner
 Recorded 23rd March 1793. Del^d. John Turner

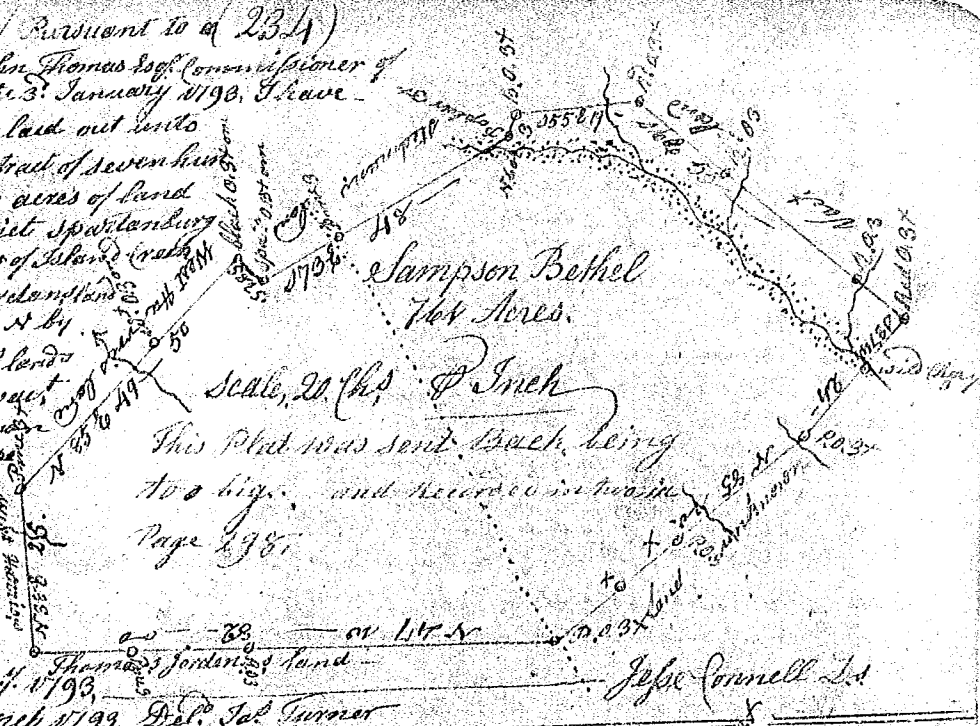

South Carolina Pursuant to a warrant from John Thomas Esq.
 Commissioner of Locations dated the 5th July 1793
 I have surveyed for James Harrison a tract of Land
 containing seven hundred & forty seven acres
 lying in Spencerville County on the mountain crest
 & the waters of Saluda river bounded by
 lines N.W. 50° N.E. 50° N.W. 60° N.E. 60°
 & S.E. 50° Originally made
 for Miles Jennings & G. George
 Harrison's land N.W. 19° by Paulsland
 S.W. 70° by Acades line & hath such
 shape form & marks as the above
 plat represents

Recorded the 10th July 1793
 W. Harrison D.S.
 Recorded the 27th March 1793
 Del^d. John Long

South Carolina Pursuant to a
 Warrant from John Thomas
 Esq. dated the 10th Dec^r.
 1793. I have admeasured
 laid out unto John Gray
 a tract of thirty three
 acres of land situate
 in Pinkney District
 Sparlandburg County
 on the side Harrison's
 land bounded on the
 N.W. by Mrs. Thompsons
 land on the N.E. by
 Jacob Harrison's land
 on the S. Littleton's
 vacant land & hath such
 shape marks boundaries
 & descending as the
 above Plat represents

Survey'd the 1st Jan^y. 1793 Del^d. John Turner
 Recorded the 3rd April 1793 Del^d. John Turner

