278

So Carolina — Pursuant to a Warrant from John Thomas Esq. Com. Ent. No. of Saluda, Dated the 24th Oct. 1793 I have admeasured & laid out unto Robert Middleton a Tract of One Thousand Acres of Land. Situate in Greenville County on a Branch of Saluda River. & Bounded N W N E & E on S. Middletons land W W and S Unknown & hath such shape & marks as the above plat represents

Certified the 31st Oct. 1793 James Gill D.S.

Recorded the 11th November 1793

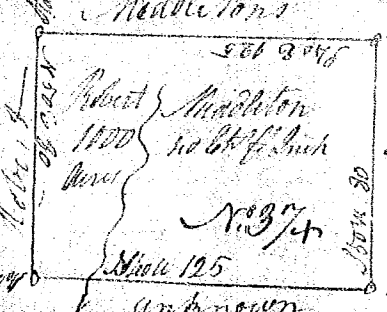

So Carolina — Pursuant to a Warrant from John Thomas Esq. Comm. Ent. North of Saluda. Dated the 16th Sept. 1793. I have admeasured & laid out unto Adam Waller a tract of 186 Acres of Land. Situate in Washington District on Branches of So Tyger River in Greenville County, Bounded by lines Running Westwards on James Grays land W by James Macaulley & Unknown N W by Jeremiah Dutton's land N E by Bayles Earle Esq. Land & hath such form & marks as the above plat Represents

Certified the 17th Sept. 1793 Jno Thomas DS

Recorded the 11th Nov. 1793 Del. Surv.

So Carolina — Pursuant to a Warrant from John Thomas Esq. Com. Ent. Dated the 7th Jan. 1793 I have admeasured & laid out unto John Evans a tract of One Hundred & Forty five Acres of Land. Situate in Greenville County on the Head Branches of Beans Creek of Saluda River. Bounded Westerly by Lines Running S 45 W & and N 85 E by land Surveyed for Samuel Baumont Esq. Lines Running N 10 E by land laid out for Wm Phillips all other sides by Vacant Land & hath such Shape & marks as the above plat Represents Given under my hand this 9th Jan. 1793

Jno Salmon DS

Recorded the 18th Nov. 1793 D. Surv.

State of So Carolina

Pursuant to a Warrant from John Thomas Esq. Ent. No. of Saluda River Dated the 18th Augt. 1793 I have admeasured & laid out unto Samuel Woods a Tract of One Thousand Acres of Land. Situate in Spartan Burgh County on Burns's Creek of Tyger & some Branches of Enoree River. Bounded by lines Running West by land Claimed by Winn N & E & Vacant by Land Laid out for James Wilford & Samuel Burns. East by land Laid out for William Crain N & E. NE & SW by Jacob Pennelton N & NE & West by Thomas Nobles Land. Containing about 1 One Hundred & Two Acres Granted to the said Woods All other Sides by Unknown & Vacant Land & hath such Shape & Corners Buttings & Boundings as the above Plat Represents.

Surveyed the 4th of Nov. 1793

James Gilgore Del. Surv.

138
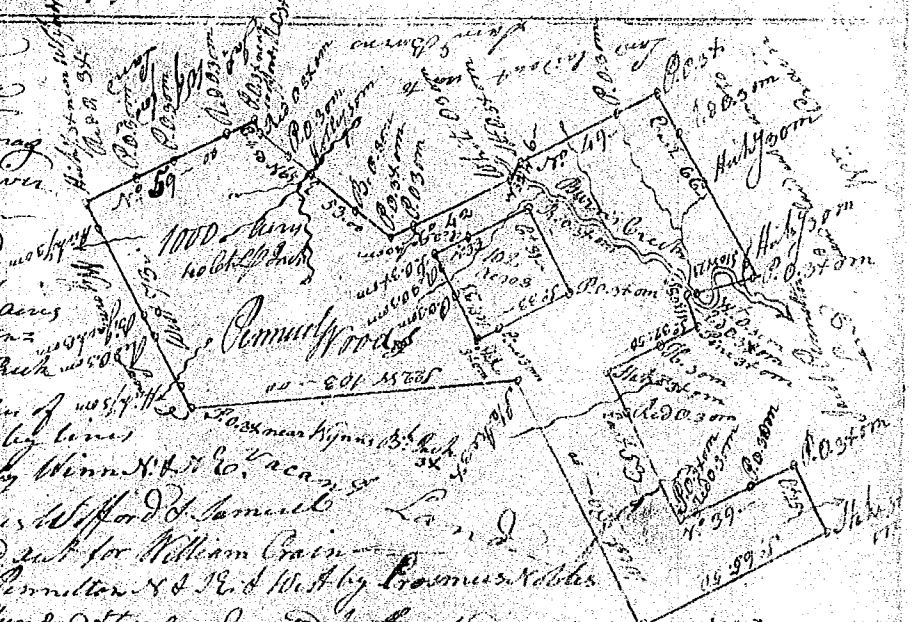
Recorded the 19th of November 1793