


State of S. Carolina Pursuant to a  
 warrant from John Thomas Esq. Comr.  
 of loc. 14 dated 12<sup>th</sup> Feb<sup>y</sup> 1794, I have  
 admeasured and laid out unto William  
 Goldsmith a tract of Three hundred and  
 ten acres of land in Pinckney District on  
 Morris Branch waters of fairforest Bound-  
 ary by a line rising N.E. N.E. by land  
 survey for Sedethon Porter, N.W. N.E. by  
 land survey for William Goldsmith, all  
 other sides on vacant or unknown lands  
 and hath such form & marks as the above Plat represents.  
 Recorded 17<sup>th</sup> March 1794. Del. Col. Brandon



State of S. Carolina Pursuant to a  
 warrant from John Thomas Esq.  
 Comr. of loc. 14 I have  
 admeasured & laid out unto  
 William Clarke a  
 Tract of Two hundred  
 & thirty four acres of land  
 in Pinckney District on the wa-  
 ters of fairforest creek, bounded  
 by a line S.W. S.E. S.E. on land survey  
 for John Stokes, S.W. S.W. S.W. on lands  
 belonging to William Clarke, S.W. S.E. on  
 on land survey for Zach. Stearns, N.E. N.W. N.W. on land survey for Jacob Hall, S.E.  
 on land survey for George Profley, N.W. on land survey for William Helms, all  
 other ~~land~~ sides on vacant or unknown lands, and hath such form & marks as the  
 above Plat represents. Surveyed 12<sup>th</sup> March 1794. Wm. Gaston Esq.  
 Recorded 17<sup>th</sup> March 1794. Del. Col. Brandon



State of S. Carolina,  
 Pursuant to a warrant from  
 John Thomas Esq. Comr. of loc. 14  
 dated 3<sup>rd</sup> March 1794, I have  
 admeasured and laid out unto  
 Col. Thomas Brandon a tract of  
 Two hundred and forty six acres  
 of land in Pinckney District  
 on the waters of fairforest  
 by lines rising S.E. S.W. by land sur-  
 for William Helms S.W. N.W. by land sur-  
 S.W. S.E. by Thomas Lyons N.E. by land survey for  
 George Profley, all other sides on vacant or unknown lands, and hath such form and marks  
 as the above Plat represents. Surveyed 11<sup>th</sup> March 1794. Wm. Gaston Esq.  
 Recorded 17<sup>th</sup> March 1794. Del. Col. Brandon

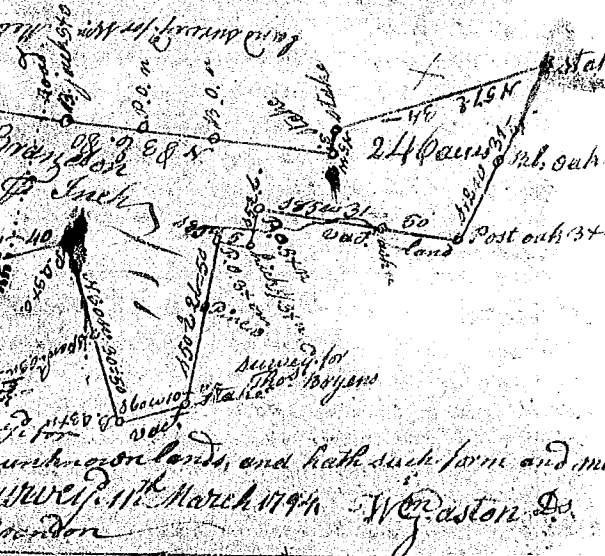

State of S. Carolina Pursuant to a warrant from John Thomas Esq.  
 Comr. of loc. 14 N<sup>o</sup> side Saluda dated 6<sup>th</sup> Jan<sup>y</sup> 1794, I have admeasured  
 and laid out unto Dabney Brooks a tract of fifty eight acres of  
 land in Laurens County on the S<sup>o</sup> fork of Duncans Creek bounded  
 by above running S.W. by Peter Kraussman's land, N.E. by land  
 Nathaniel Gorham S.W. by land survey for John Gray, all other  
 sides by land unknown, and hath such form and marks as the a-  
 bove Plat represents. Surveyed 6<sup>th</sup> Feb<sup>y</sup> 1794.  
 Recorded 5<sup>th</sup> April 1794. Del. Self W. P. Rowson Esq.

