


State of S<sup>c</sup> Carolina Pursuant to a warrant  
 from John Thomas Esq. Com<sup>r</sup> of Loc<sup>n</sup> N<sup>o</sup> 1 Saluda  
 dated 15<sup>th</sup> Dec<sup>r</sup> 1795, I have admeasured and  
 laid out unto Henry Gray a tract of  
 four hundred & sixty one acres  
 of land in Greenville County  
 on Hooper's Creek of Saluda riv<sup>r</sup>  
 bounded SW. & S. E. by Thurston's  
 land N. E. - S. E. & S. W. by Dun-  
 -ninghams land N. W. by Robin-  
 -sons land N. W. by unknown  
 land W. Thachers x and  
 such shape and form as  
 the above plat represents  
 Survey 16<sup>th</sup> Dec<sup>r</sup> 1795.  
 recorded 29<sup>th</sup> Dec<sup>r</sup> 1795 Joseph Benson

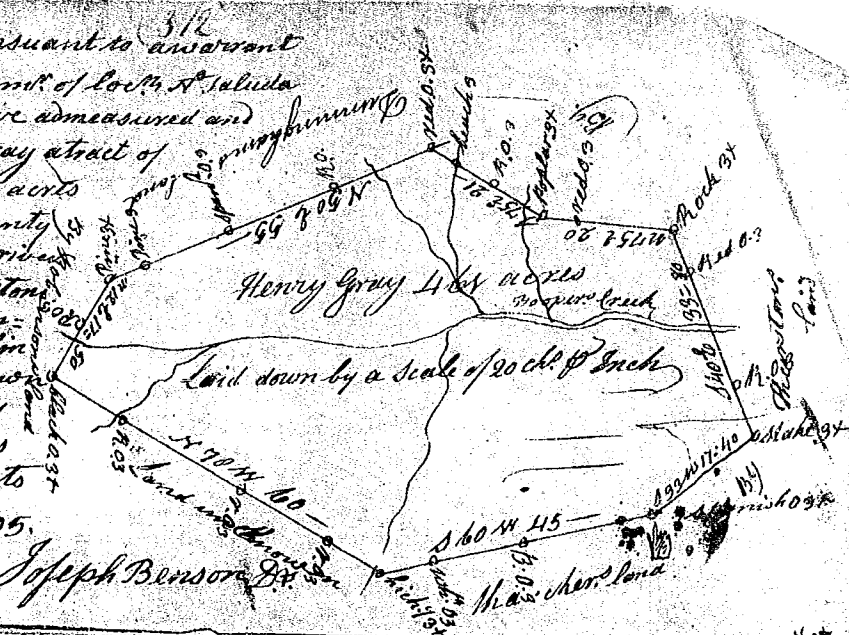

State of S<sup>c</sup> Carolina Pursuant to  
 a warrant from John Thomas Esq.  
 Com<sup>r</sup> of Locations S<sup>c</sup> side Saluda  
 I have admeasured and laid out  
 unto John Leek a tract of  
 three hundred & sixty eight  
 acres of land, in Union County  
 in Pinckney District, on the  
 branch of Broad river and  
 Peoples Creek. bounded N. by  
 his own land, S. by vacant land  
 Et. by land of John Macanson.  
 W. by lands of Col. David Hopkins  
 and hath such shape form and  
 marks as the above plat represents  
 Survey by me the 24<sup>th</sup> Oct<sup>r</sup> 1795.  
 recorded 1<sup>st</sup> Febr<sup>y</sup> 1796 Vardry W. Bee  
 Dec<sup>r</sup> 1795

