
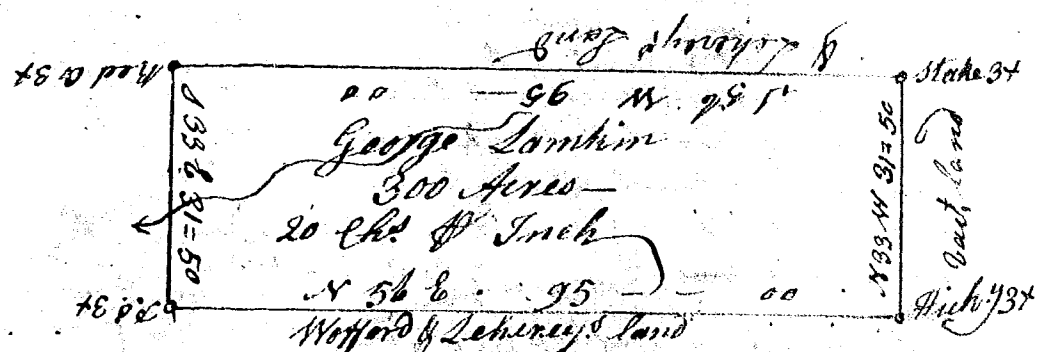


State of S^c Carolina (401)
 Pursuant to a warrant from John Thomas Esq. Com^r of Locations dated 20th febr^y. 1797, I have admeasured and laid out unto William Dalton a tract of forty three acres of land in Pinckney District, Spartanburg County on branches of north fork of Pacolat River bounded W. by Thomson's land N. by S. Dalton's land, E. by Jackson's land S. by Vacant land, and hath such shape, form & marks as the above plat represents, Survey, 22nd febr^y. 1797, J. Young Jun^r.
 Recorded 18th April 1797, Del. self

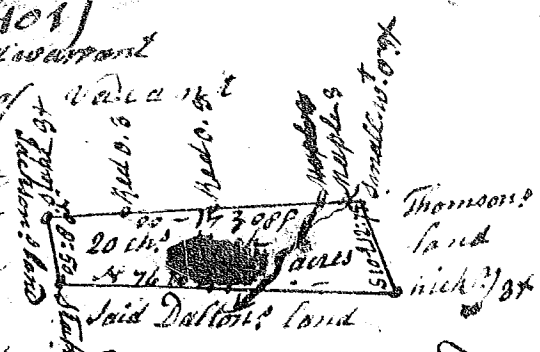

Pursuant to a warrant from John Thomas Esq. Com^r of Locations dated 20th febr^y. 1796, I have admeasured and laid out unto George Lambin a tract of Three hundred acres of land, in Pinckney District, in Spartanburg County on a branch of Pacolat river, Bounded S.E. & S.W. by land laid out for William Wofford & Leheray, N.E. by vacant land, and hath such shape, marks, buttings & boundings as the above plat represents, Survey, 12th March 1796, —
 Recorded 9th May 1797, Del. self, Jesse Connell D.