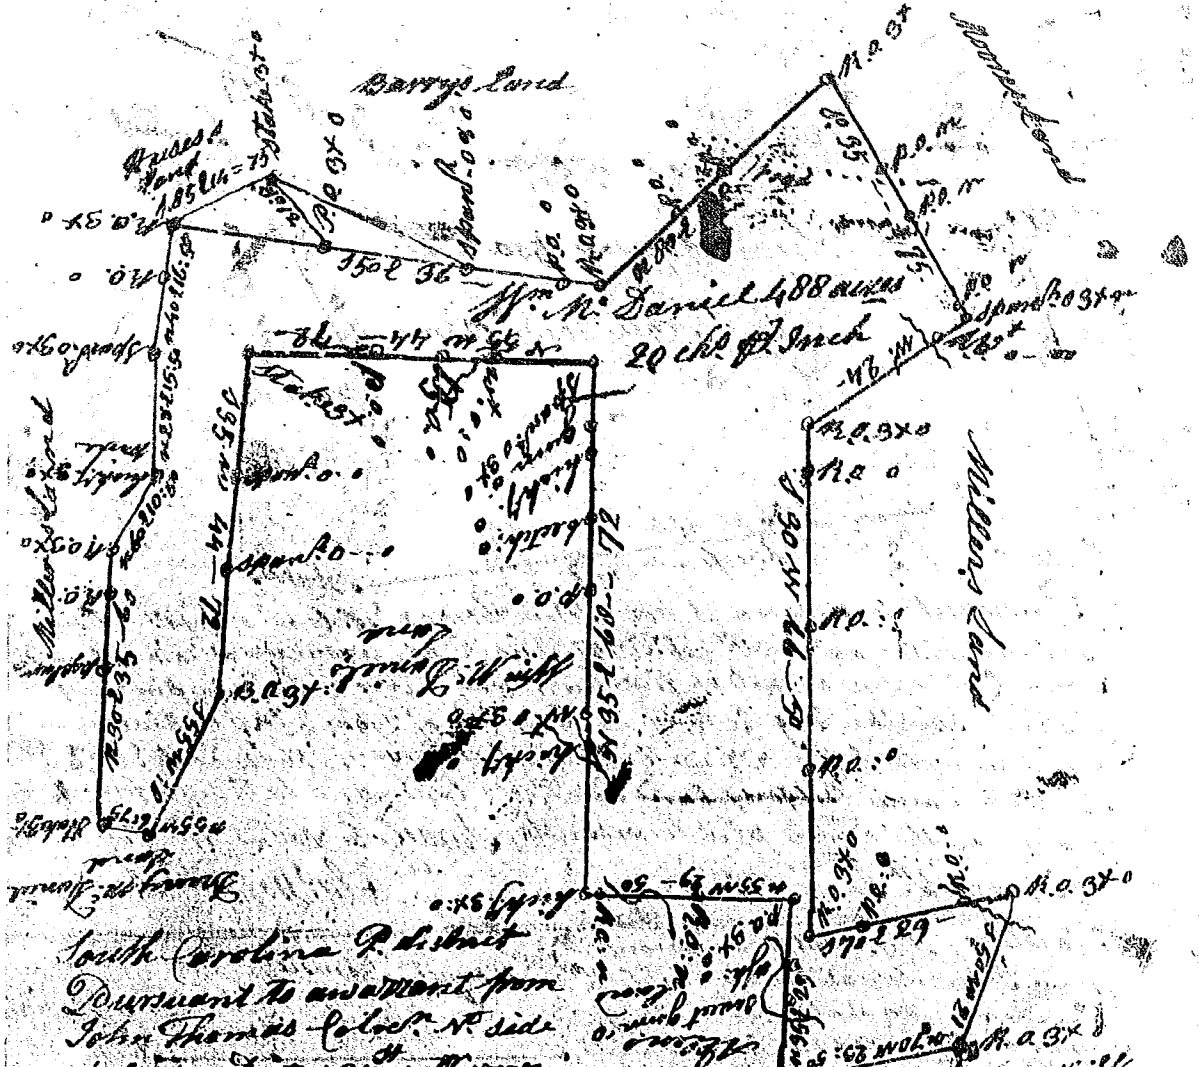

South Carolina District
Pursuant to an Warrant from
John Thomas Esqr. Surveyor
to me Directed Dated 31st Octr. 1787,
I have admeasured and laid
out unto William M.c Daniel fourhundred four
and eighty eighty acres of Land Spartanburg County on
branches of Tyger River Running N. E. with Millers Land
S.E. with Hughes's Land S. & S.E. & N.E. with Barrys Land
do. with Moores Land W. & S.W. & S.E. with Millers S.W. & N.E.W. and
N.E with Wm. M.c Daniel N.W. allong N.W. Survey M.c Daniels
and Hath such shape and marks as the above plat
Represents, Surveyed 17th Jan.y 1798 Jn.o Hafford D.s
Recorded 19th Jan.y 1798, — Rec.d Sat.y