


South Carolina Pursuant to a warrant
 from John Thomas - Const of Location
 side Saluda dated 13th Sept 1798
 I have administered and laid out unto
 Jacob Cain tract of three hundred &
 four acres of land in Green-ville
 County on both sides of Fall Creek
 of the head waters of Saluda
 Bounded N. by James Lach's
 land by land laid out for John Stage
 all other sides by vacant land, and
 such shape and marks as the above plat
 Represents. Certified 21st Sept 1798 -
 George Salmon D.S.

Recorded 12th Jan'y 1799

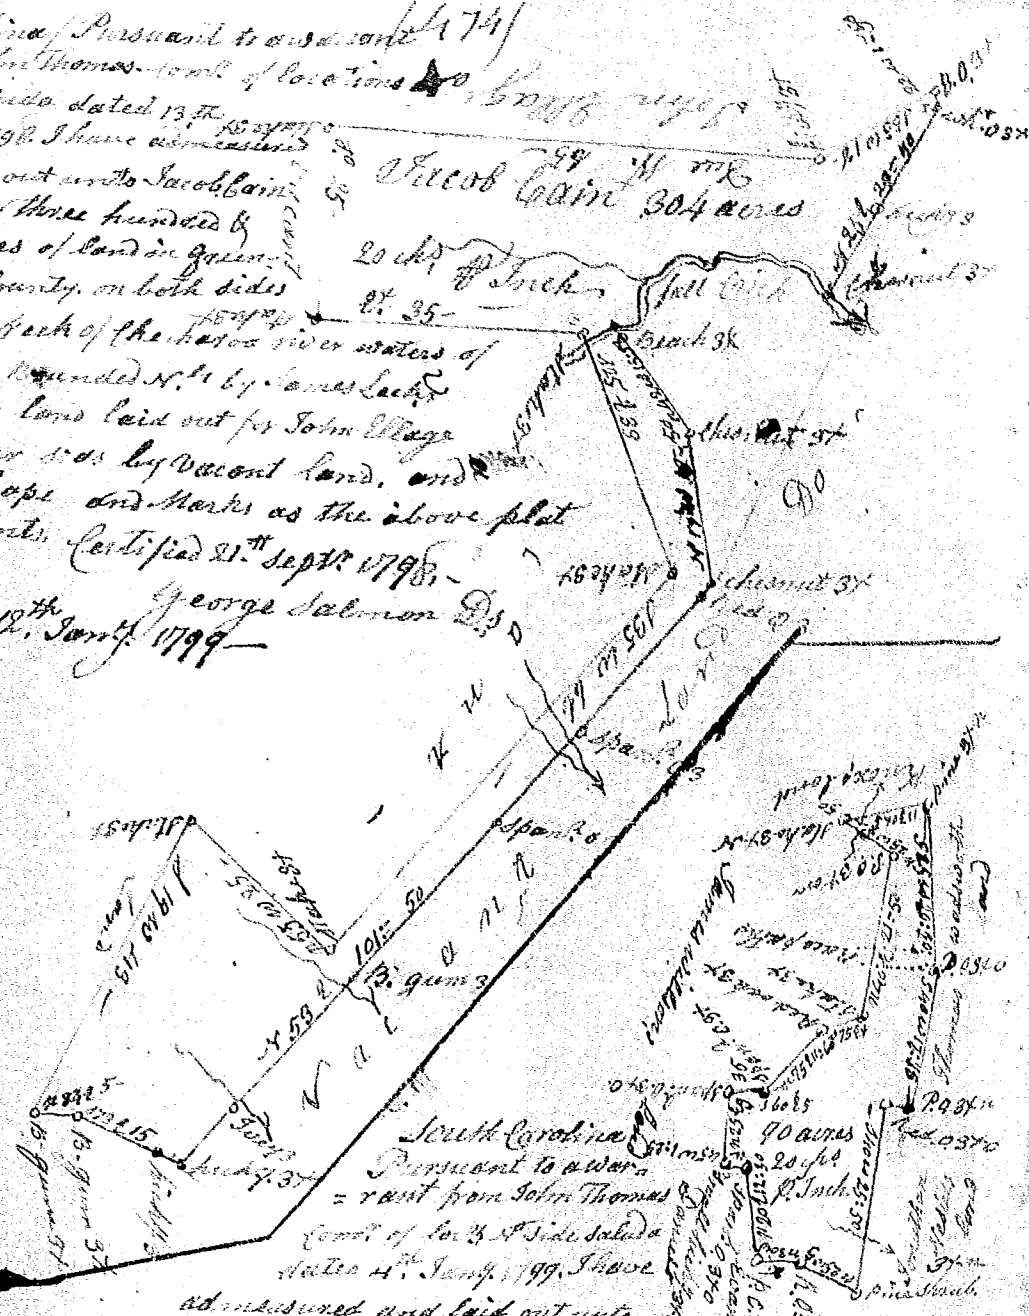

South Carolina Pursuant to a warrant
 from John Thomas Const of Location
 side Saluda dated 14th Jan'y 1799 I have
 administered and laid out unto


