1477

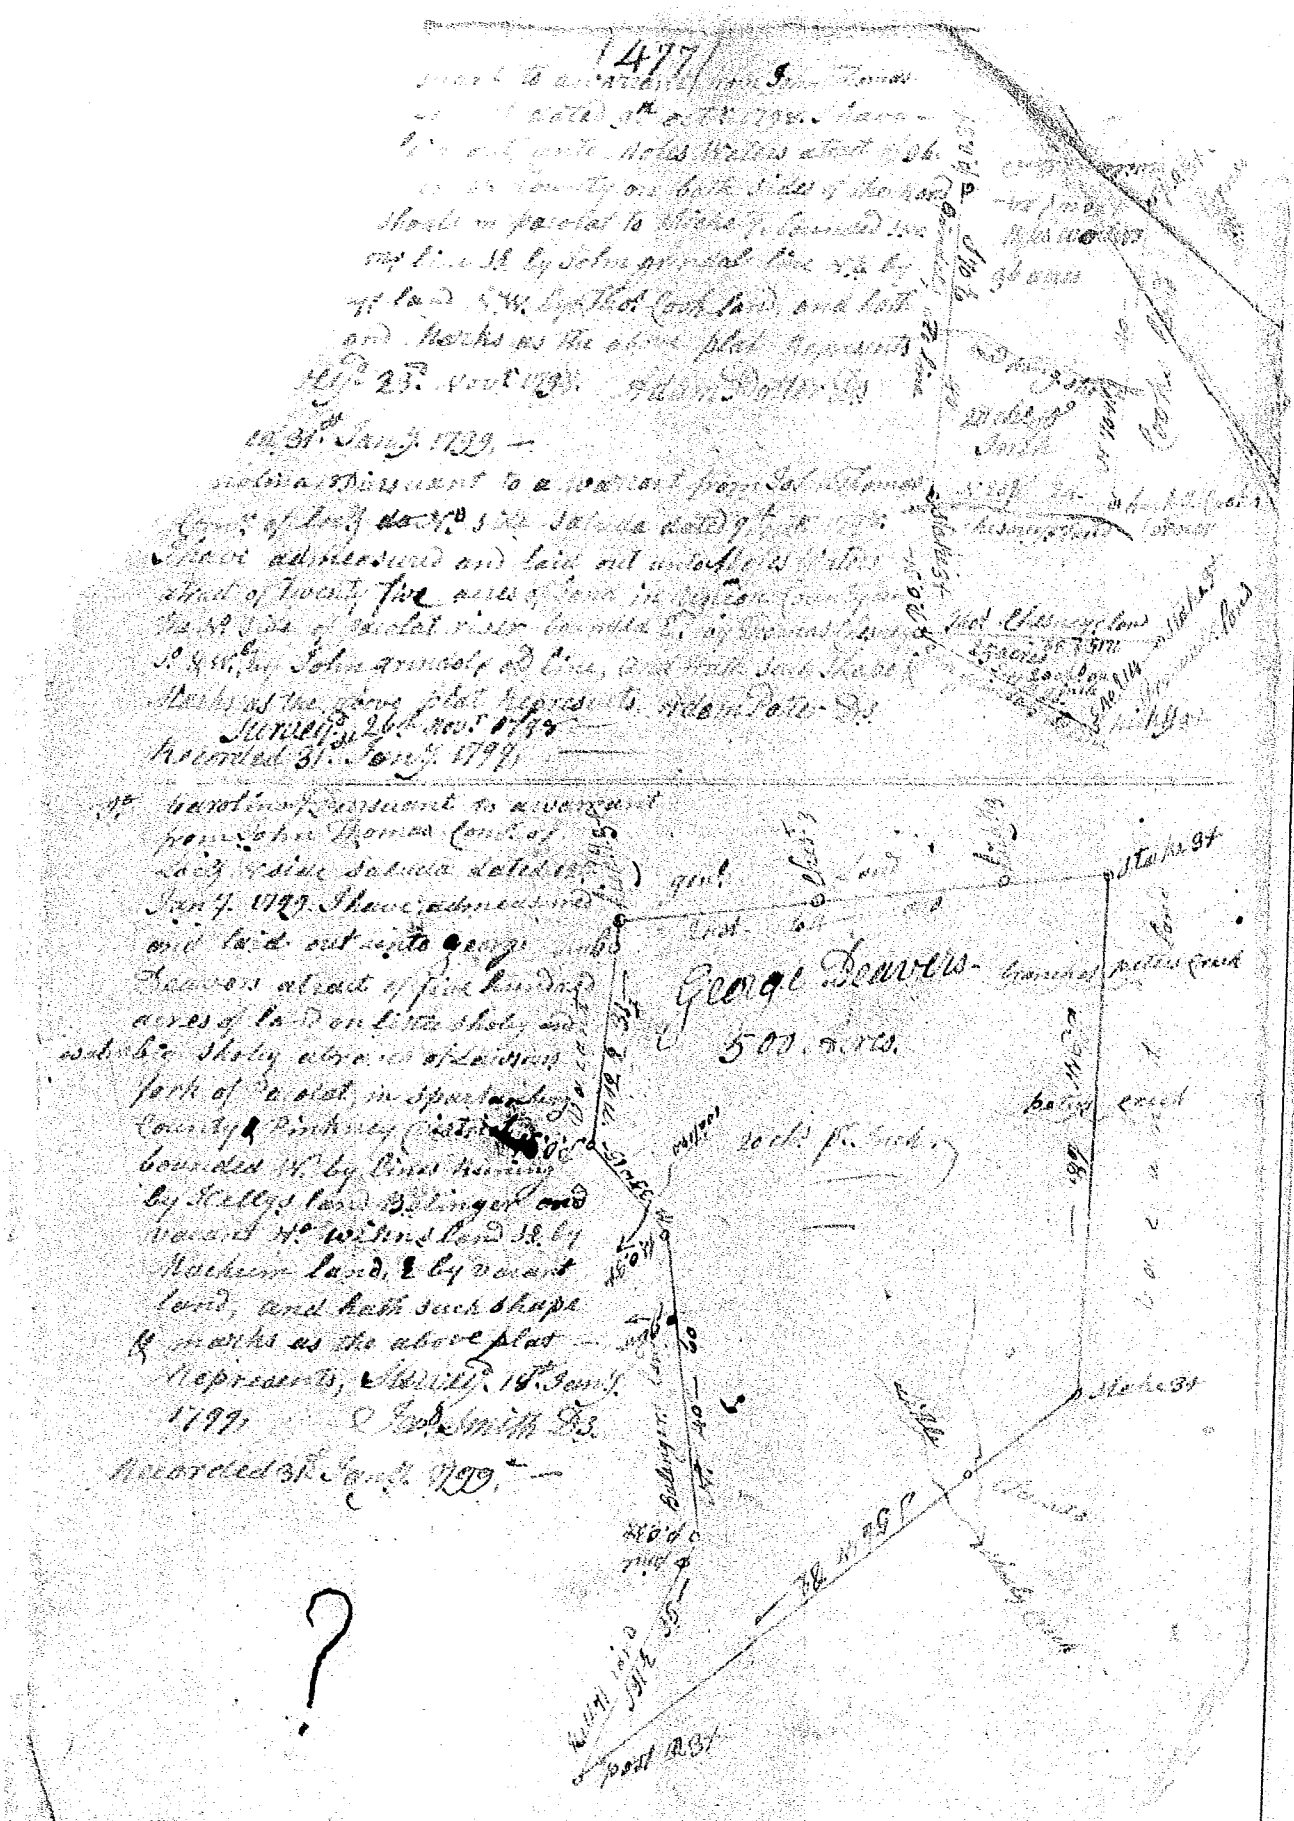

?