



Map of land to
 John Thomas land, side of the
 river. In 1799, I have surveyed for Samuel
 Daniel a tract of land, water together 190
 acres lying chiefly in and on the south side
 of Broad river at the mouth of Middle branch
 Spartanburg County, including land above the
 Middle creek also part of the land
 bounded to by Daniel to a W by
 Daniel and another land on the other
 side by the River and back such shape
 and marks butting boundaries as the above
 plat represents Surveyed 1st Feby. 1799.
 Recorded 1st Feby. 1799. — John Smith De.



Pursuant to a
 warrant from 1808
 John Thomas land
 of land dated 25th Jan'y
 1799, I have surveyed
 for John Hammett 96 acres
 of land in
 about of 99 acres of land in
 Spartanburg County on the
 W side of Broad river adjoining the same bounded to by said John
 Hammett's land W. by Wofford's & others lands N. by 31st of John Hammett's
 land, W. by the river, and both such shape and marks as the above
 plat represents. Surveyed 5th Jan'y. 1799. John Smith De.
 Recorded 5th Feby. 1799

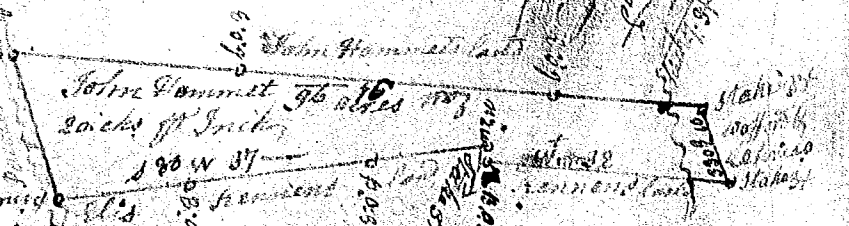

Pursuant to a warrant from John Thomas, cont of land
 side of the river, dated 25th Jan'y. 1799, I have surveyed and laid out
 Abel Pearson a tract of one hundred and three — Am. brose 103
 acres in Mecklenburg County on two small branches of Duncan's Creek
 bounded by a line running S 62 W by John
 Duncan's land, same in heirs of Ambrose
 Whiten 170 E 82 W. by miles Whiten's land
 180 E by William Reed, & 103 E 82 W
 by Charles Whiten, and both such shape and marks as
 the above plat represents.
 Surveyed 14th Feby. 1799 —
 Recorded 14th Feby. 1799 —
 Abel Pearson Sur. De.

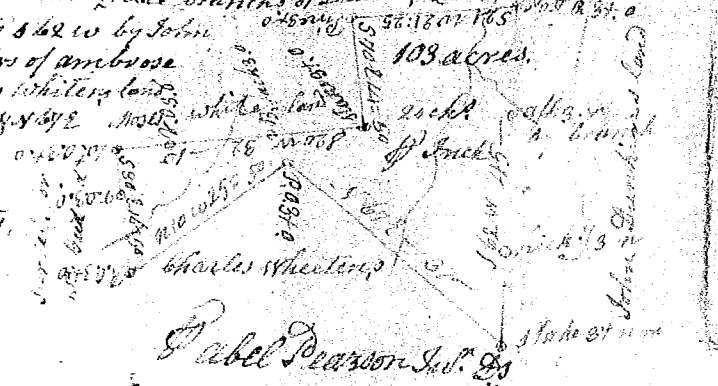

?