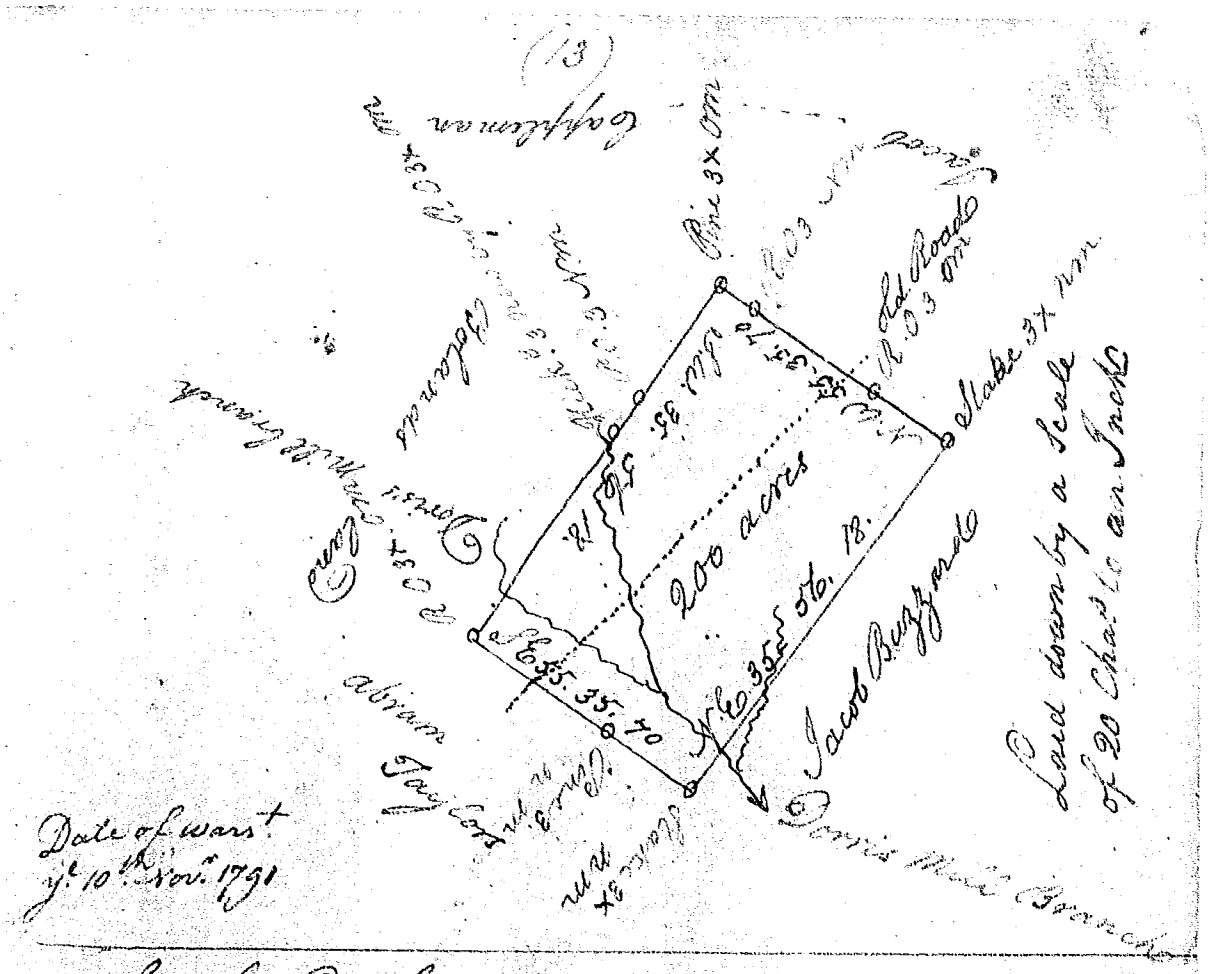

South Carolina

Pursuant to a warrant from John Thomas Esqr Comr of Locations in Ninety Six district I have admeasured & laid out unto Robert Powell a tract of Two hundred acres of land situate in Newberry County on a small Branch of Cannons Creek called Dorns ellis Branch the waters of Broad River & bath such Boundaries Buttings form Shape Marks &c. as the above plat Represents.

Certified this 15th Nov. 1791.

J. Harbert
D.S.