


S^c Carolina Pursuant to a warrant from John Thomas Esq^r,
Com^r of Locations N. Saluda, I have admeasured & laid out unto
Adam Thomson a Tract of three hundred & sixty three acres
of Land in Union County on the Branches of Thickett
and S^e side thereof bounded N^o by Land of Chas Littlejohn
S^e by land of John Beckham on the East by Abram
Gossett's Land and West by his own Land & hath such shape
and Marks as the above plat Represents —
Surveyed the 21st of May 1793

Vardry M. Bee
DS

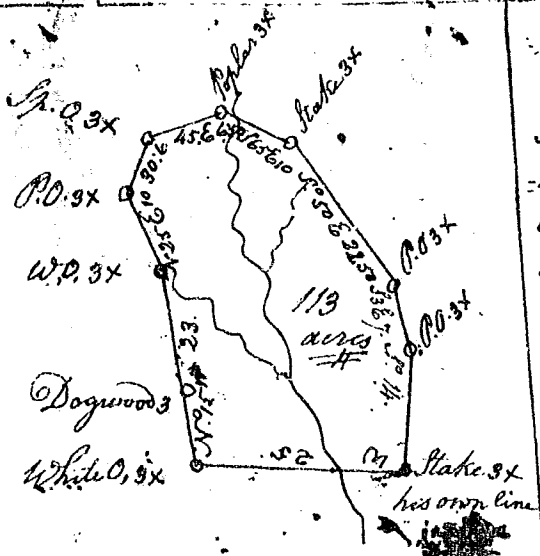

By a Scale of 20
Chs to an Inch

S^c Carolina Pursuant to a warrant from
John Thomas Esq^r, Com^r of Locations N. Salu-
da, I have admeasured & laid out unto In^o
Christian Franks a Tract of One hundred
and thirteen acres of Land in Union County
on the N^o Side of Pacolet River on a small
Creek, bounded S^e by Land of Bartlett
Whartons W^o by N^o by Land of In^o Beckham
E. by Land of Edw. Atkins and hath
such shape & Marks as the above
plat Represents —

Surveyed the 22^o May 1793

Vardry M. Bee
DS