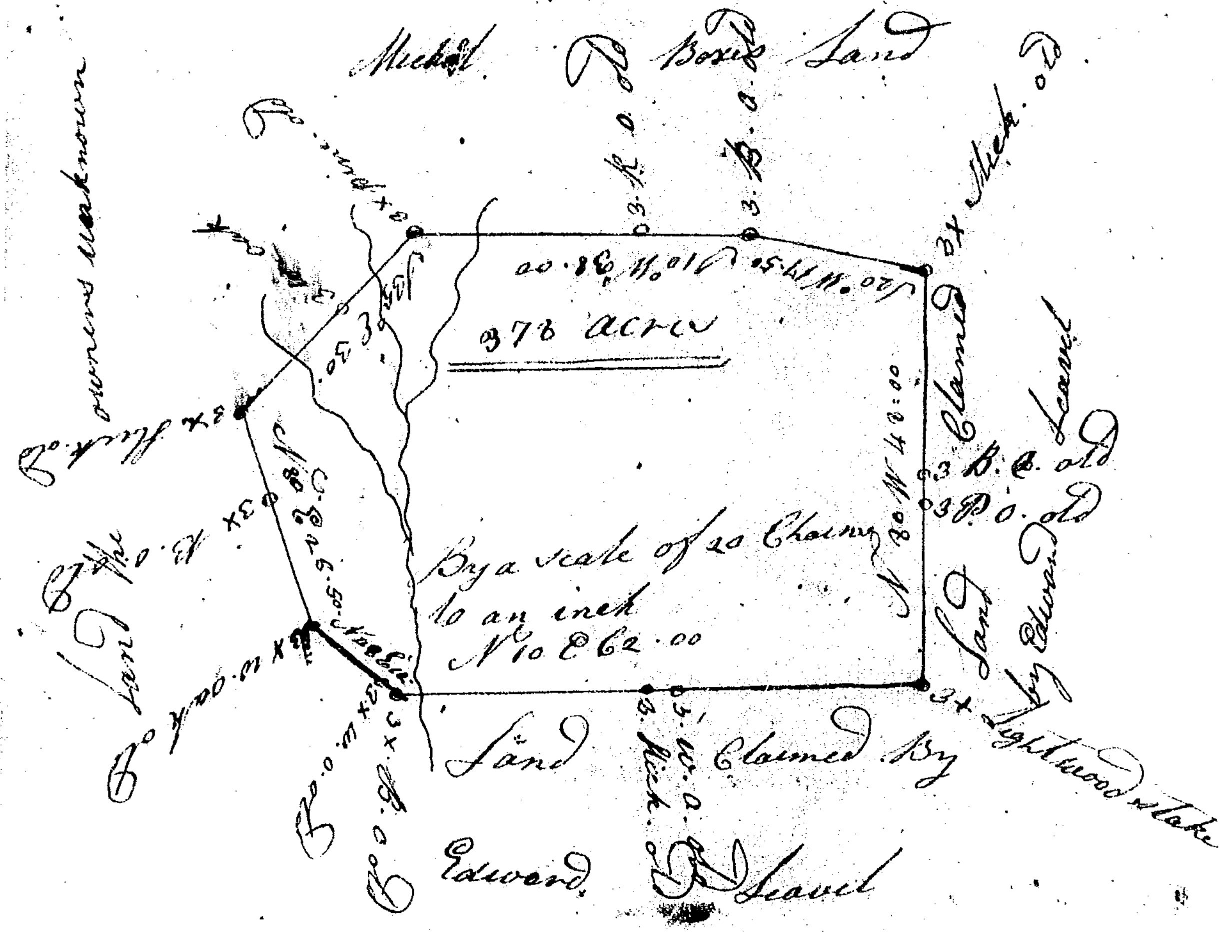

State of South Carolina

pursuant to a worrent to me derected by John Thomas Esqure Commistioner of Location on the North side of Saludy River I have admeasured and laid out unto Patrick Cunningham and Jacob Bowman a plantation or tract of Land Containing three hundred and Seventy Eight acres in Larence County On walnut Creek the waters of reby River and hath Such Buttings Boundings Shapes and marks as the above plat Doth represent certified this 19th November 1793

Per me P Cunningham