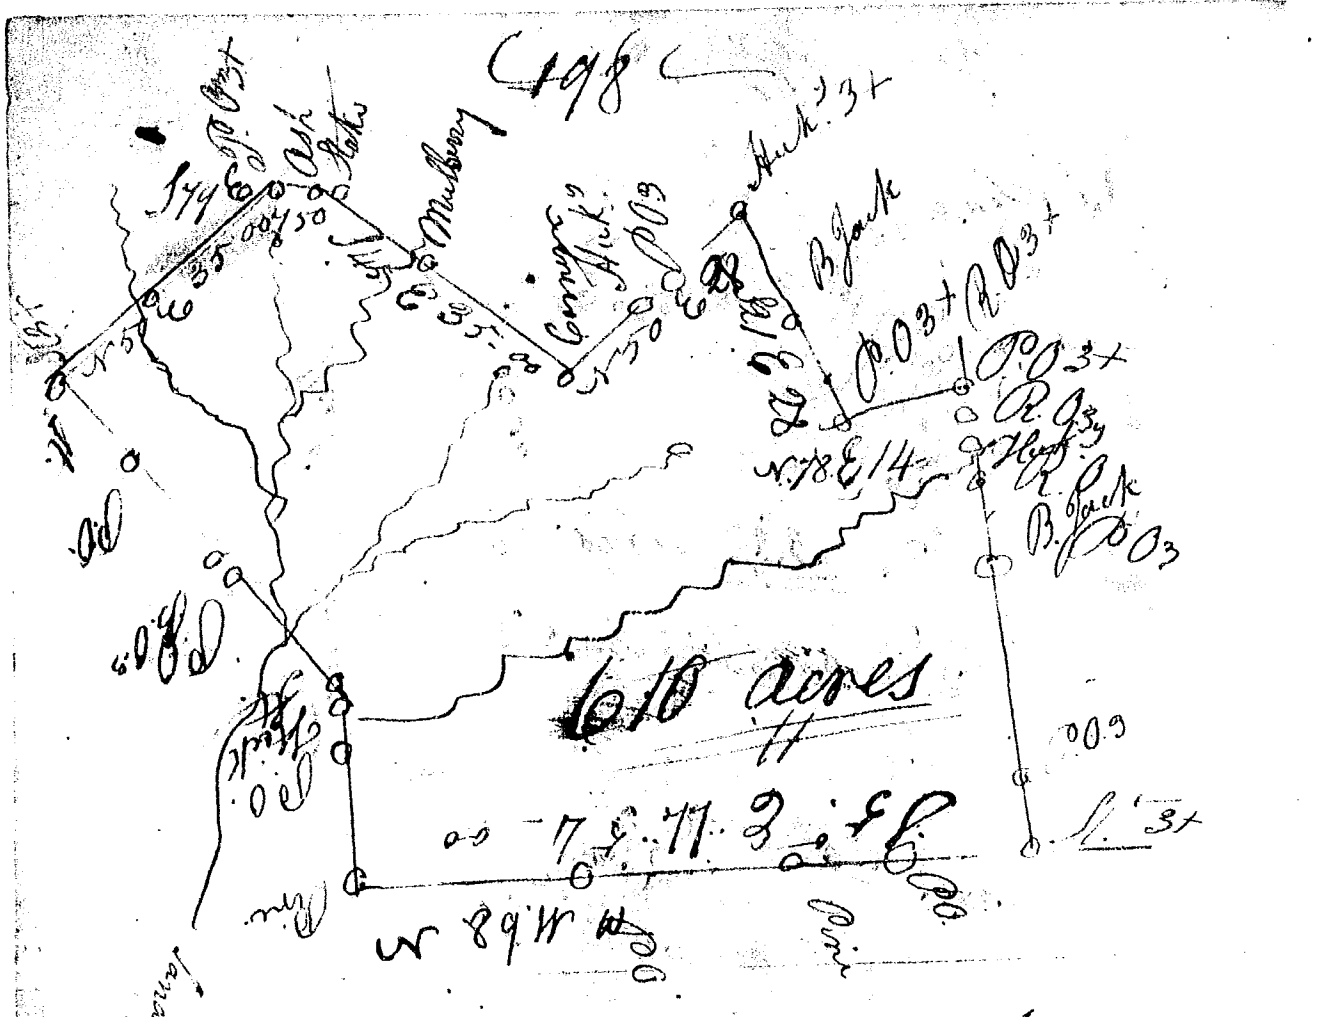

Pursuant to a warrant from John Thomas Esq. Com.r of Locations No. 5 dated the 9th of December 1784 and to me directed I have admeasured and laid out unto Daniel McAlio a tract of Six hundred & ten acres of Land on a Creek called Sandy Run Waters of Little River and hath such form & marks as the above plat Represents

Given under my hand this 17th day of February 1785

Wm Brown Sr