


Island 240
 Survey for Dan. Tollison 16 acres, the 4th of July 1794
 by D. Hugh Thomas, D.S.
 date of warrant 28 March 94

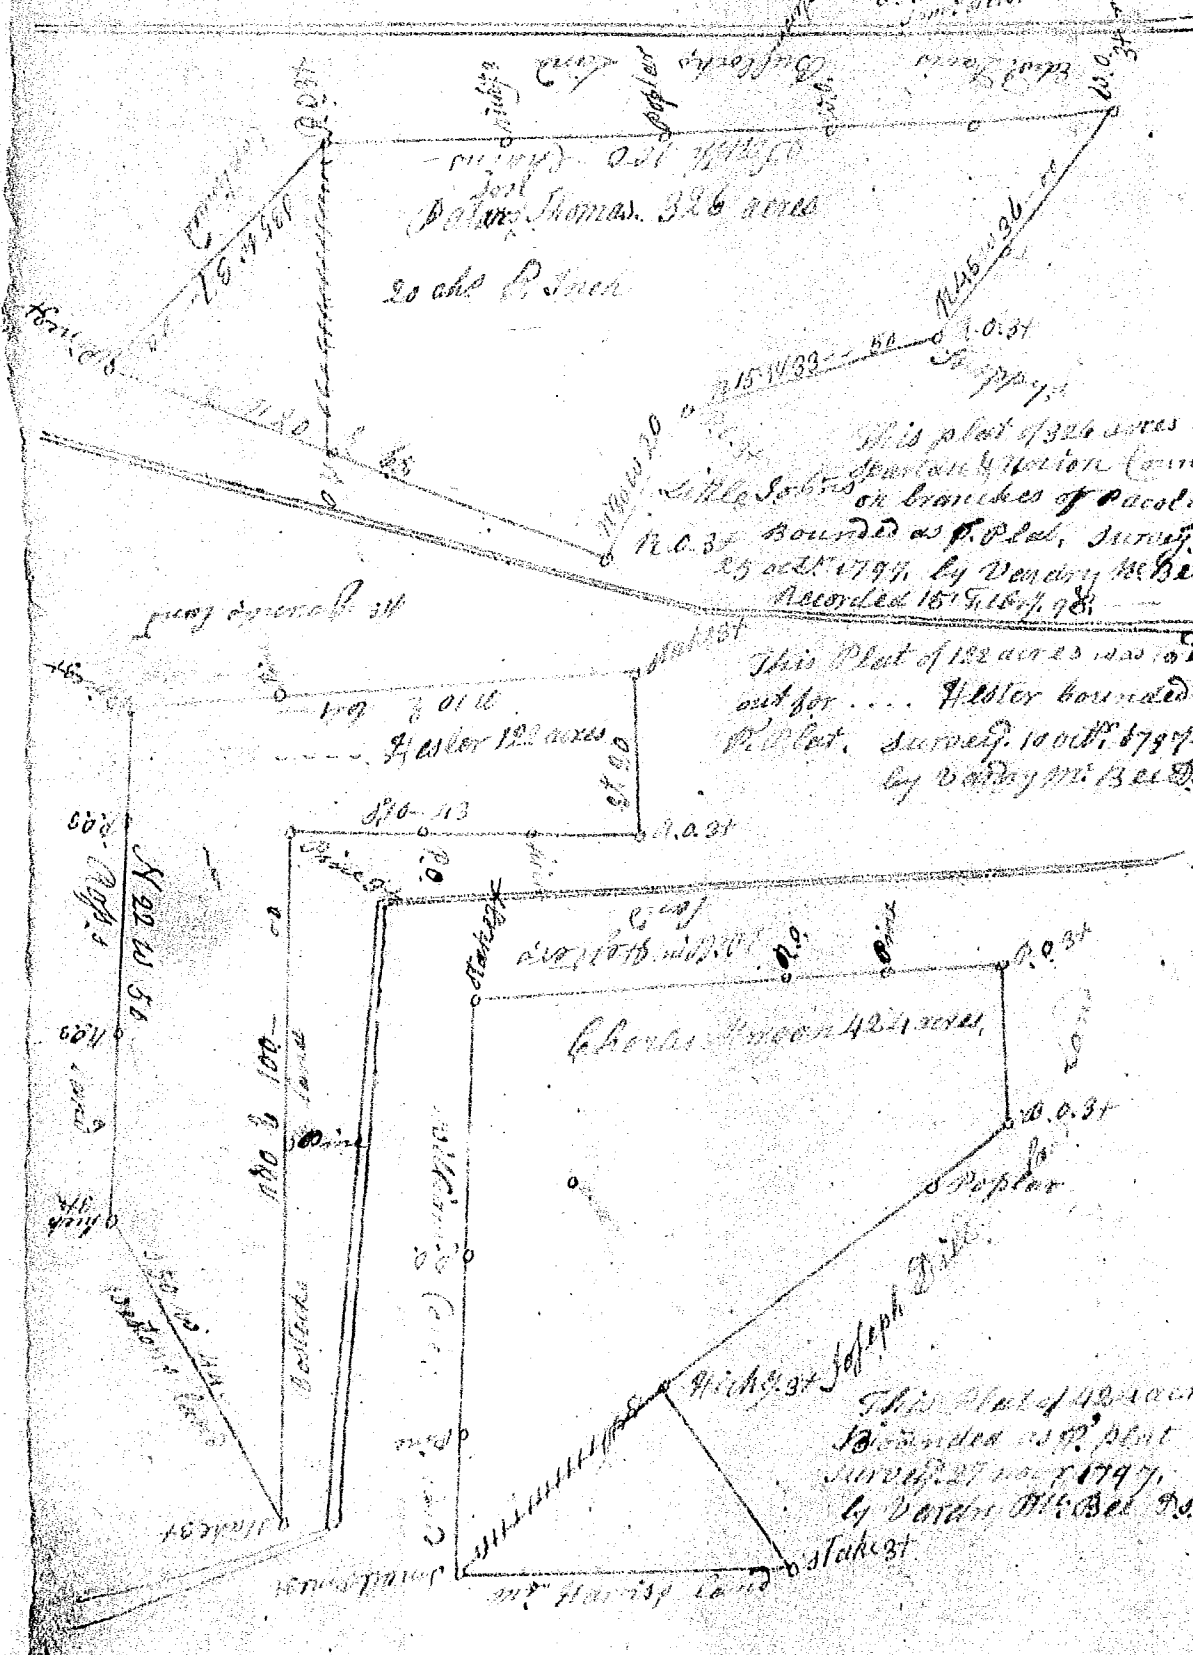

This plot of 326 acres in
 N.C. 37 bounded as P. Plat. Survey the
 25th Oct 1794, by Varday Mc Bee D.S.
 recorded 15th 9th 98

This Plot of 122 acres was laid
 out for ... Hester bounded as
 P. Plat. Survey 10th Oct 1794
 by Varday Mc Bee D.S.

This Plot of 424 acres
 bounded as P. Plat
 by Varday Mc Bee D.S.