


(116)

South Carolina.

Pursuant to a warrant from John Thomas, Comr. of Soc^y N side Saluda river dated 15th sept^r 1801

I have advertised and laid out unto John Coley a tract of Three hundred & thirty seven acres of land in Laurens district on the foot of mountain & creek

as small creek of Rainbow Creek water of Meedy River bounded S.E. on Arnold's land & Samuel Swans land N.E. on Israel Eastwood's John Armstrong's lands N.W. on Joseph Downs's land S.W. on vacant or unknown land, and hath such shape & marks as the above plat represents. Merely 19th Sept^r 1801. Recorded 16th Nov^r 1801.

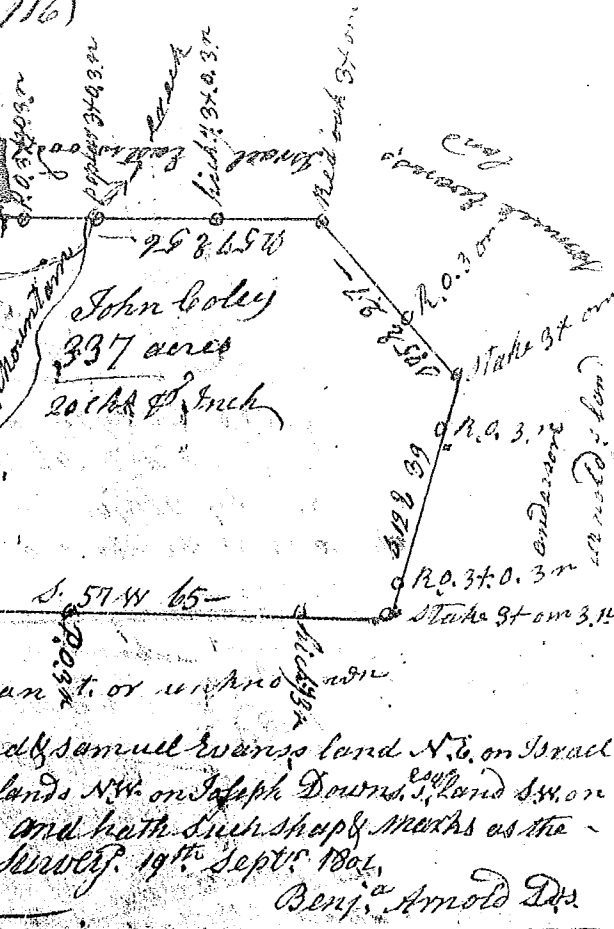

Benjⁿ Arnold De^y

South Carolina Pursuant to a warrant

from John Thomas, Comr. of Soc^y N side Saluda

5th Nov^r 1801, I have laid out unto William

Owings a tract of eight hundred & sixty

five acres of land in Laurens district

on Peachlins branch of Rayburns

Creek bounding with lines N with

Tate's land W with Joseph Alson's

S. & S.W. Joseph Hammons, S.E. with

Owings & William Owings land, and

hath such shape and marks as the

above plat represents. Merely 12th

Nov^r 1801

Recorded 16th Nov^r 1801



John Wofford De^y