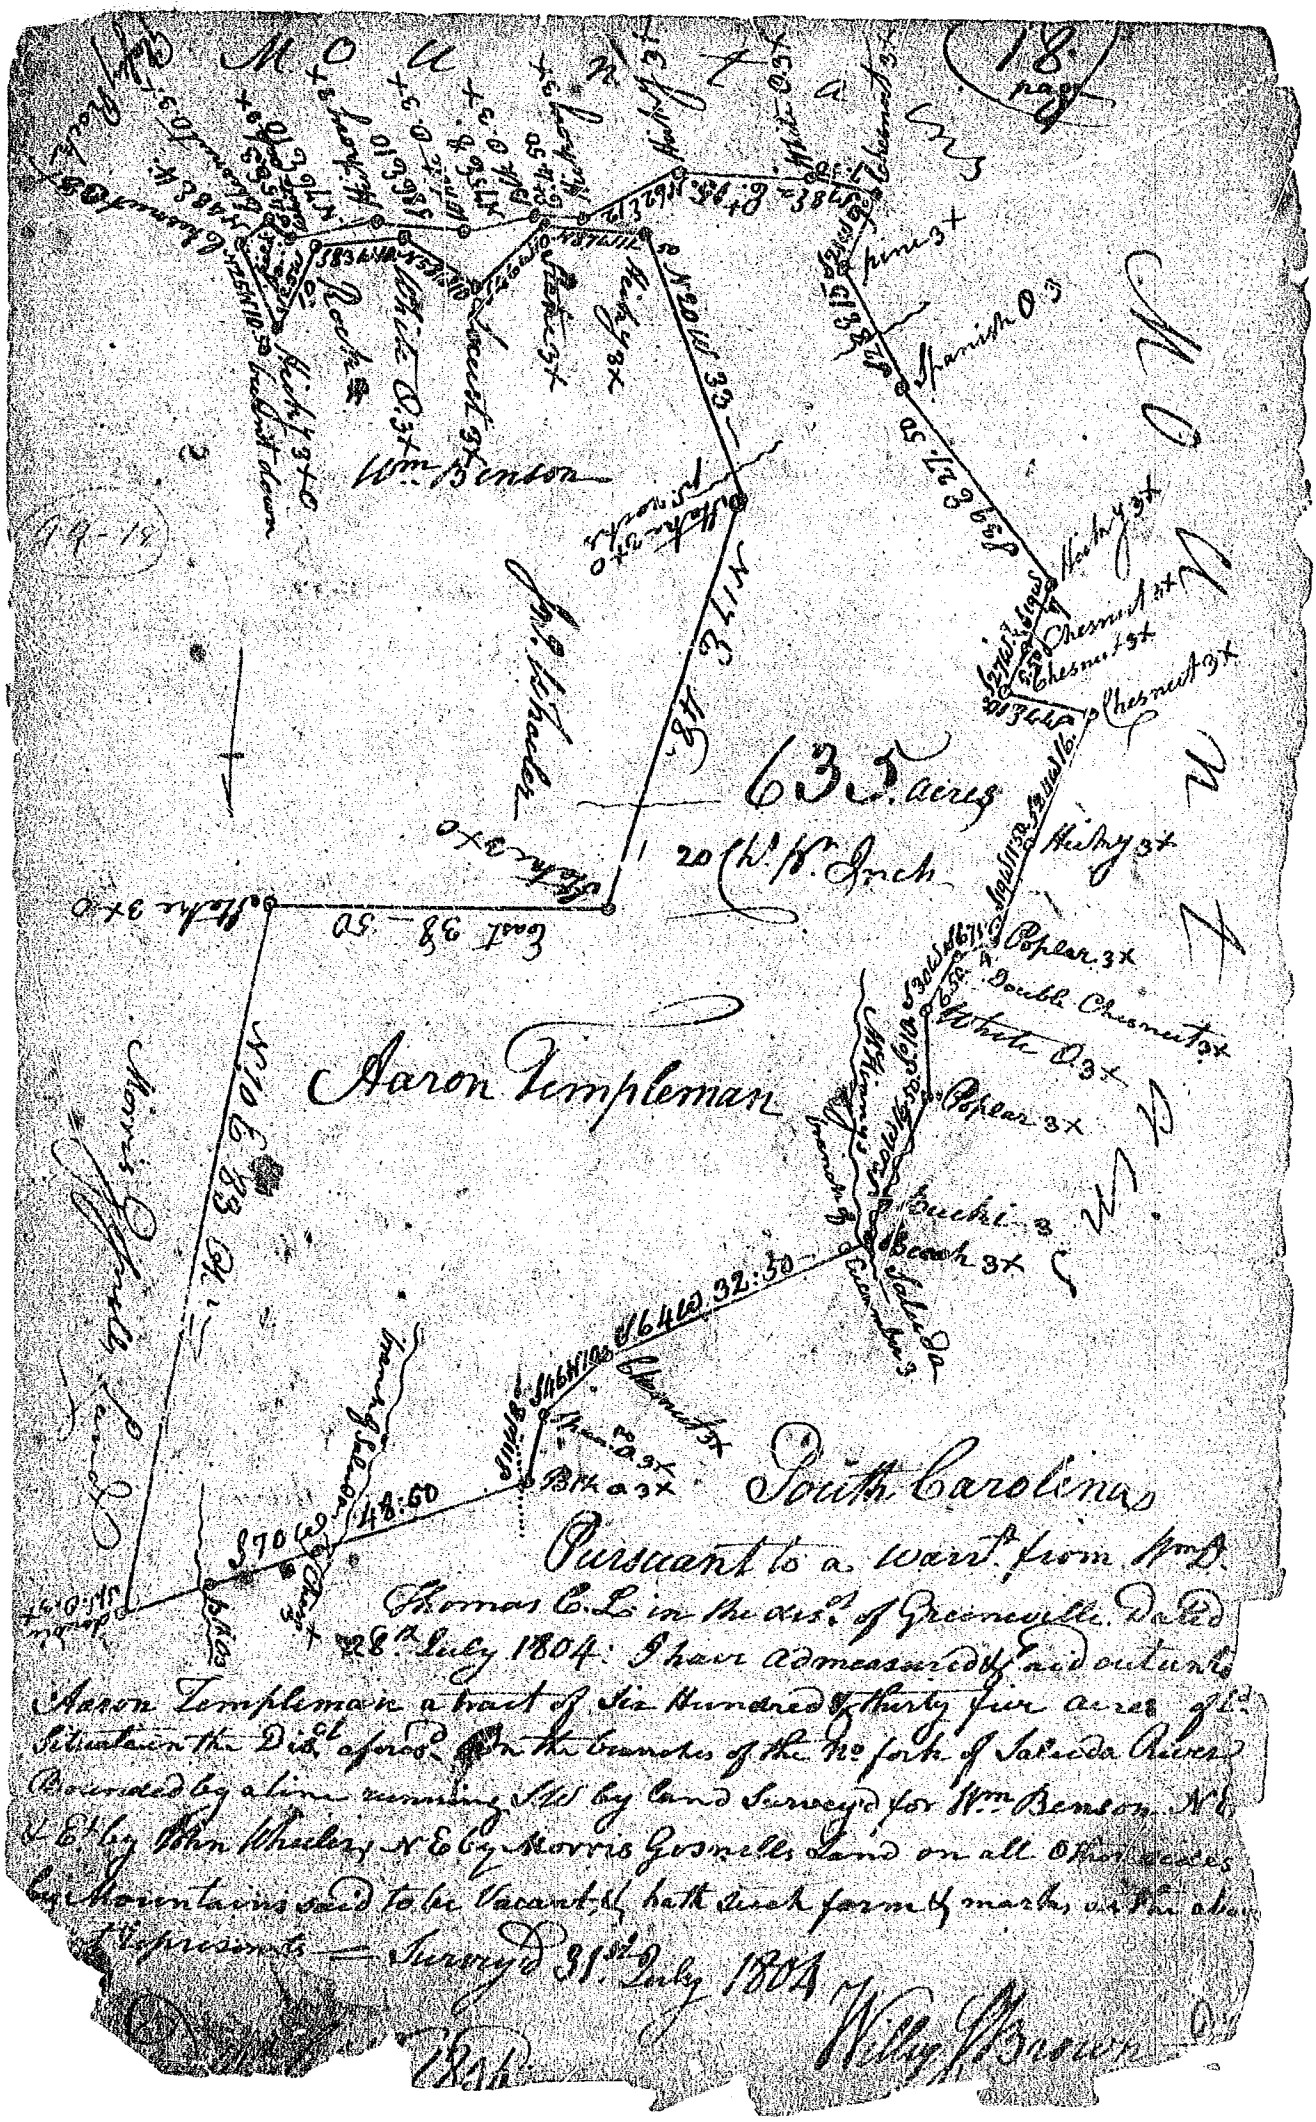
18 pages
Aaron Templeman
South Carolina
Pursuant to a warrt. from Wm. D. Thomas C.L.C. in the Dist. of Greenville. Dated 28th July 1804. I have admeasured & laid out unto Aaron Templeman a tract of Six Hundred & thirty five acres &c. Situate in the Dist. aforesd. on the branches of the No. fork of Saluda River. Bounded by a line running S.W. by Land Surveyd for Wm. Benson. N.E. & E. by John Wheeley N.E. by Morris Gosnells Land on all other sides by Vacancies said to be Vacant & hath such form & marks as the above Plat represents — Surveyd 31st July 1804
Wm. Benson
Wm. Benson
Wheeley
Morris Gosnells
Saluda
Poplar
Double Chesnut
Hickory
Beech
Buckeye
Chesnut
