63

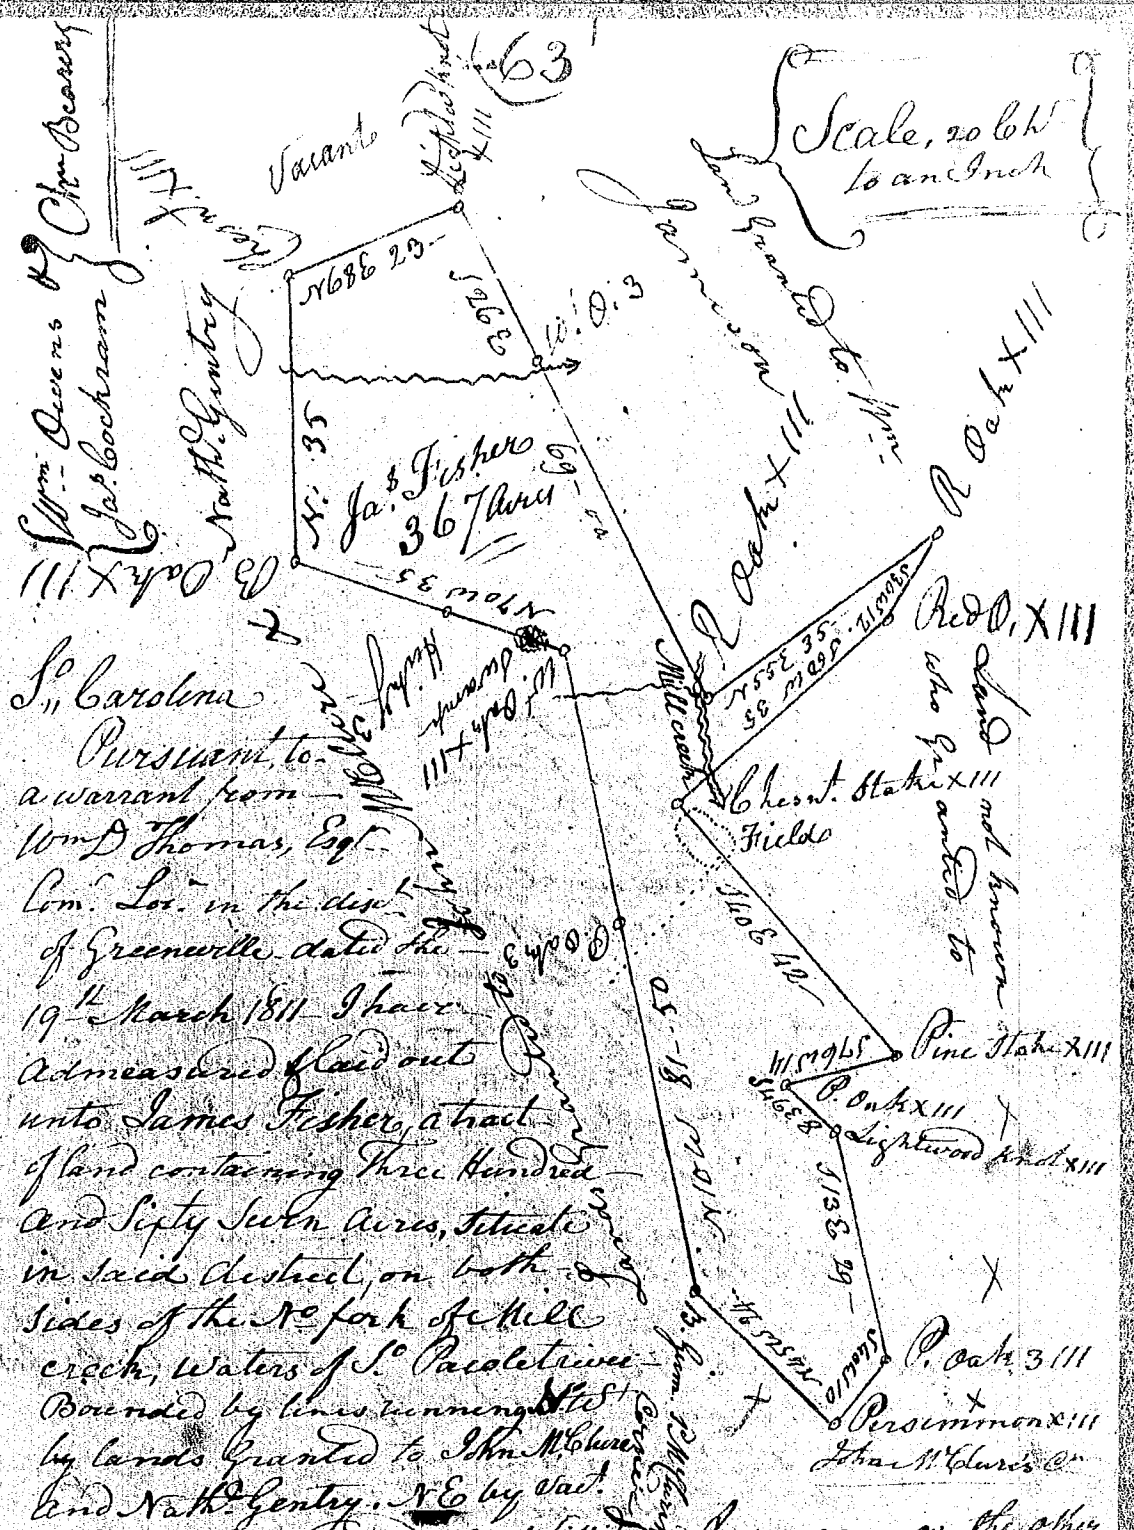

So. Carolina

Pursuant to a warrant from Wm. D. Thomas, Esqr. Comr. Lor. in the dist. of Greenville dated the 19th March 1811 I have admeasured & laid out unto James Fisher, a tract of land containing Three Hundred and Sixty Seven Acres, Situate in said district, on both sides of the No. fork of Mill creek, Waters of So. Pacoletriver Bounded by lines running N.W. by lands Granted to John McClure and Nath. Gentry. N.E. by Vact. S.E. by land Granted to William Jameson, on the other sides by lands laid out, not known who for, & hath such form and marks as the above plat represents

Surveyd the 21st day of March 1811

Jas. Whitten D. Sur.

Recorded this 25th March 1811

Dil. Mr. Owens