South Carolina

Pursuant to a warrant from Wm D. Thomas Comr Lovr in the district of Greenville dated the 15th July 1812, I have admeasured & laid out unto Jonathan Potts a tract of land, Containing, one hundd & Sixty five acres — Situate in the said District, on Branches of Gap Creek, & of the Devils fork waters of the Middle fork of Saluda, ~~River~~ bounded by lines running N.E. wardly by land Surveyd for Thomas Wood & Ephraim Ellis. S.E.ly by land Surveyd for Thomas Gaw and on all other sides by Vacant land, and hath such form & marks as the above plat Represents. Surveyd the 16th July 1812.

Recorded the 31st July 1812 — Wm H. Cooke Dep. Sr.

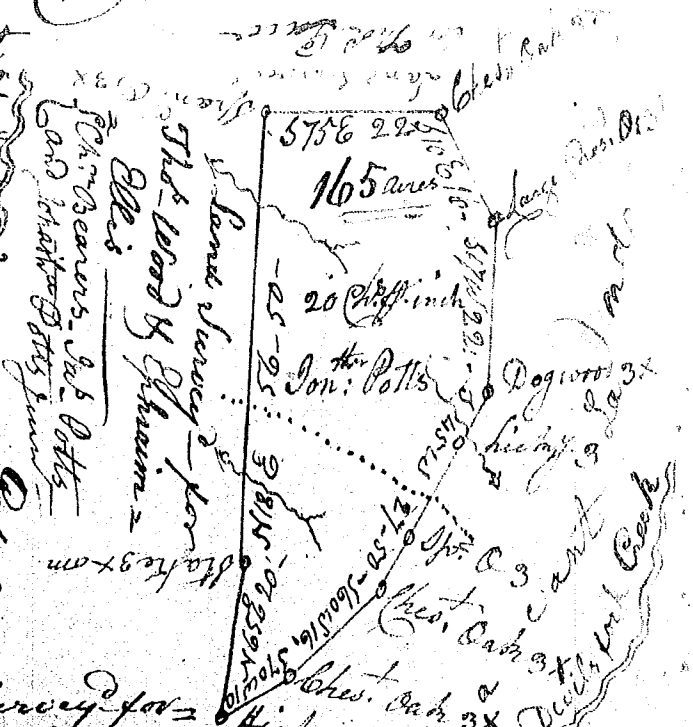

St So Carolina

Pursuant to a warrant from Wm D. Thomas, Comr Lovr in Greenville district dated the 24th of Augt 1812, I have admeasured & laid out unto William Cannaday a tract of Ninety five acres of land. Situate in Greenville district, on a branch of Durbins Creek, Bounded N. & NW. by Benneiah & James Cannadays Lands W. by John Howards & So & S.E. by Philips Housewoth's Land, & hath such form & marks as the above plat represents

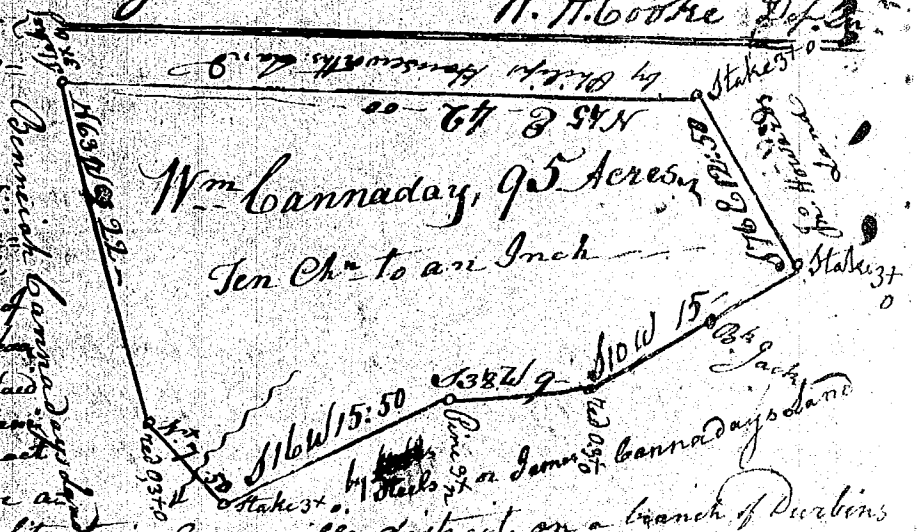

Certified by me this 27th Augt 1812

Recorded the 19th Septr 1812 — Wm Gilbert Junr Dep. Sr.