


South Carolina

73

Pursuant to a warrant from
 Wm D. Thomas Esq - Com^r Law^r
 in the district of Greenville
 with date the 10th day
 of July 1812 - I have
 admeas, & laid out unto
 Asahel Thompson
 a tract of one hundred
 & forty acres of land
 Situate in S^d district
 on the waters of the
 middle fork of
 Tygar & bounded
 by a line run. N 68° E by
 land granted to A. Thompson
 N W by land granted to Bright
 Precut & S W by land survey - for Jonas Dawson & E. & S. by
 laid out to Wm Gowen & hath such form & marks as the
 above plat represents - Surveyed 15th July 1812
 Recorded the 2nd day
 of Nov^r 1812

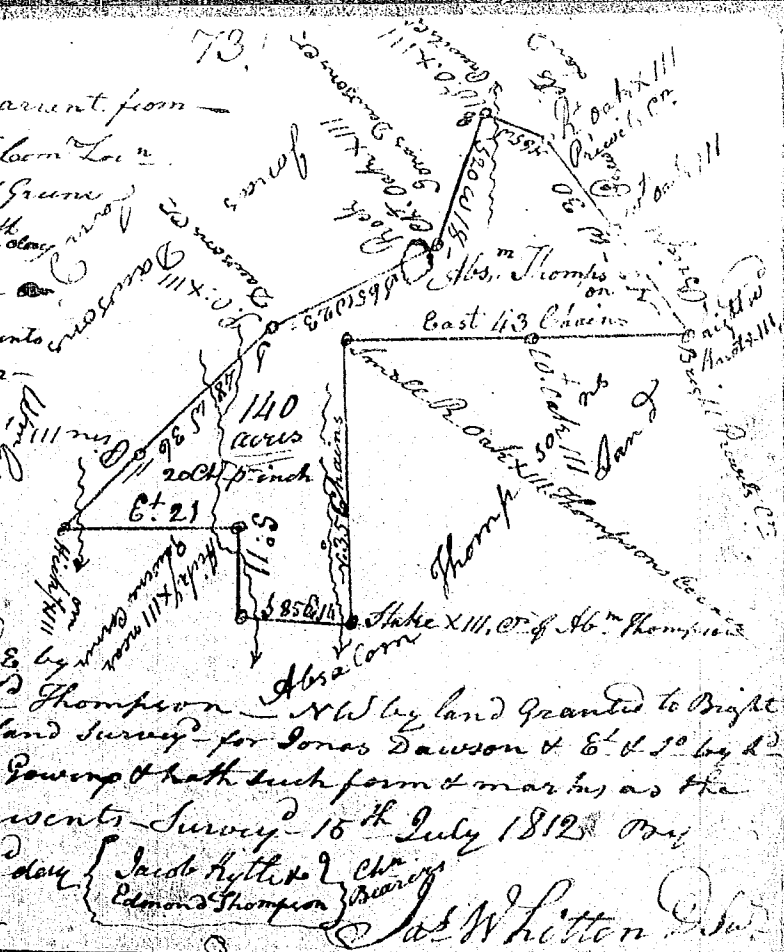

South Carolina

Pursuant to a
 warrant from Wm D.
 Thomas Com^r Law^r in
 Greenville District
 dated the 1st Sept 1812
 I have admeas & laid
 out unto John Brewer
 a tract of land Cont^y
 One Hundred & thirty
 five acres Situate
 in the said district on
 the South fork of the
 Beady River, bounded by a line run
 N^e by Carbin Cornetts land N W by Nathan Berrys S W
 by Micajah Berrys & East by William Youngs land & hath
 form & marks as the above plat represents -
 Surveyed the 2nd day of Sept 1812



Recorded 16th Nov^r 1812

Micajah Berrys