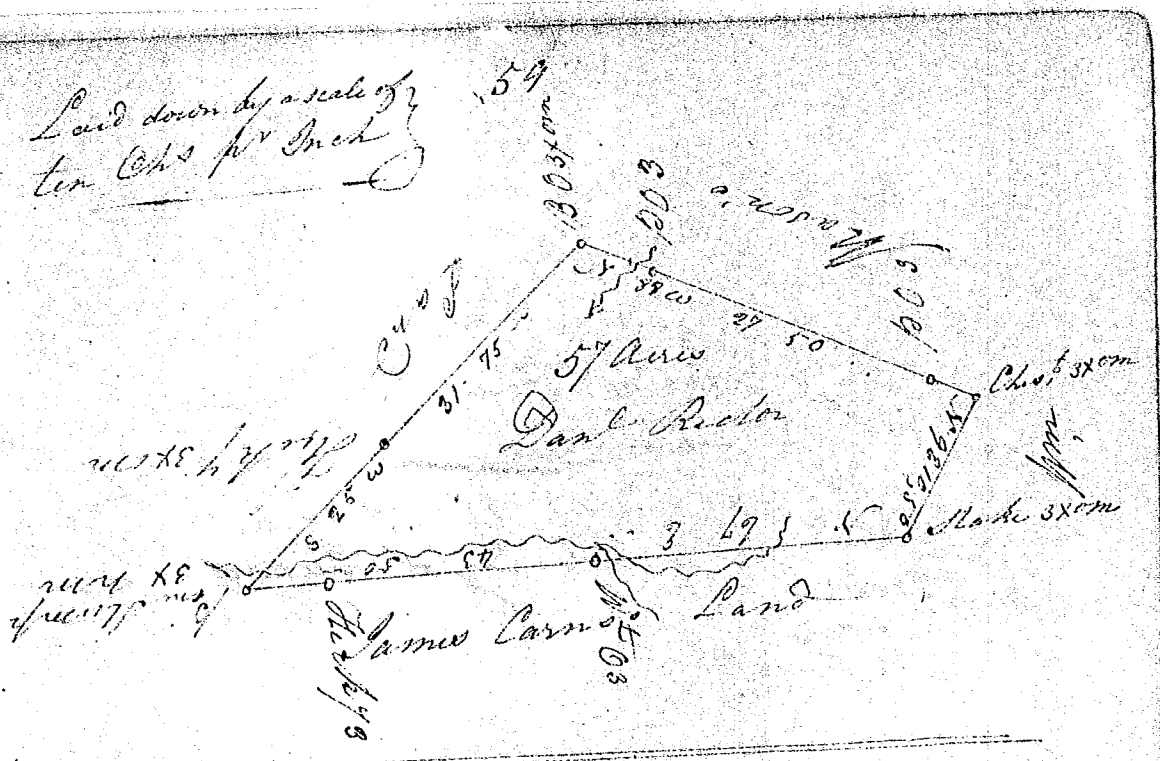

South Carolina.

Pursuant to a warrant from John Young Comm.r of Locations for the District of Glynnville, bearing date the 12th day of Dec.r 1821. I have caused to be admeasured & laid out unto Daniel Rector a tract of fifty seven Acres of Land, on branches of Mudlick Creek Waters of Emmet River, bounded by James Carmichael Line Running N.E. and on all other sides by Vacant Lands, and has such form, and marks as the above Plat represents.

Survey'd and Certified by me this 15th day of Dec.r 1821.

B Griffith D.S

Recorded the 24th day of Jan.y 1822

John Young C.L