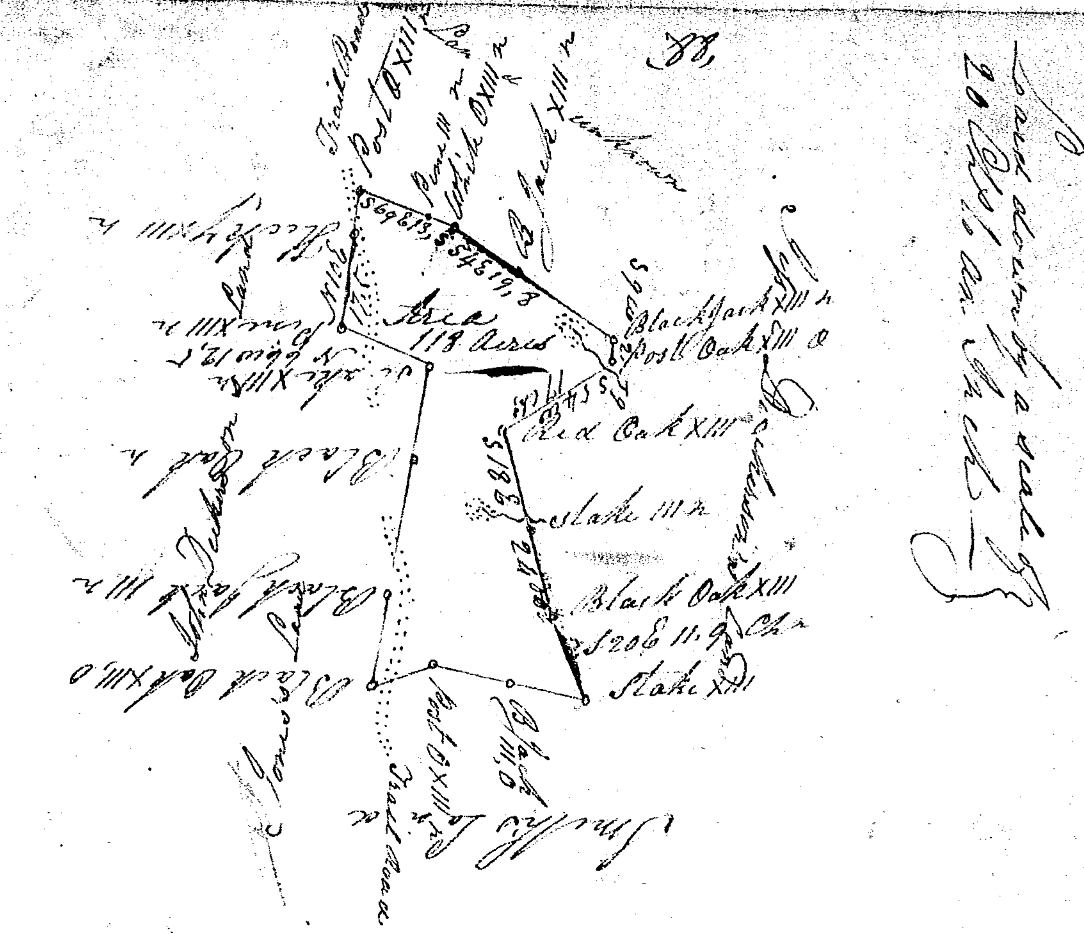

South Carolina

Pursuant to a warrant from John Young Commissioner of Locations in Greenville District dated the 1st day of March 1824, I have admeasured and laid out unto Jesse Dickerson a tract of Land Containing one hundred and Eighteen Acres, Situate in the Said district, on a small branch of the Reedy fork of Reedy River, Bounded by Lines Running S W & S E by Jesse Dickerson, N & S W by Smith's Land, N E & N W by Adam Jones's Land N E by John Dickerson's land and on all other sides by land unknown, and hath such form and marks as the above Plat represents.

Survey the 5th day of March 1824.

Recorded the 5th day of April 1824
John Young Clk