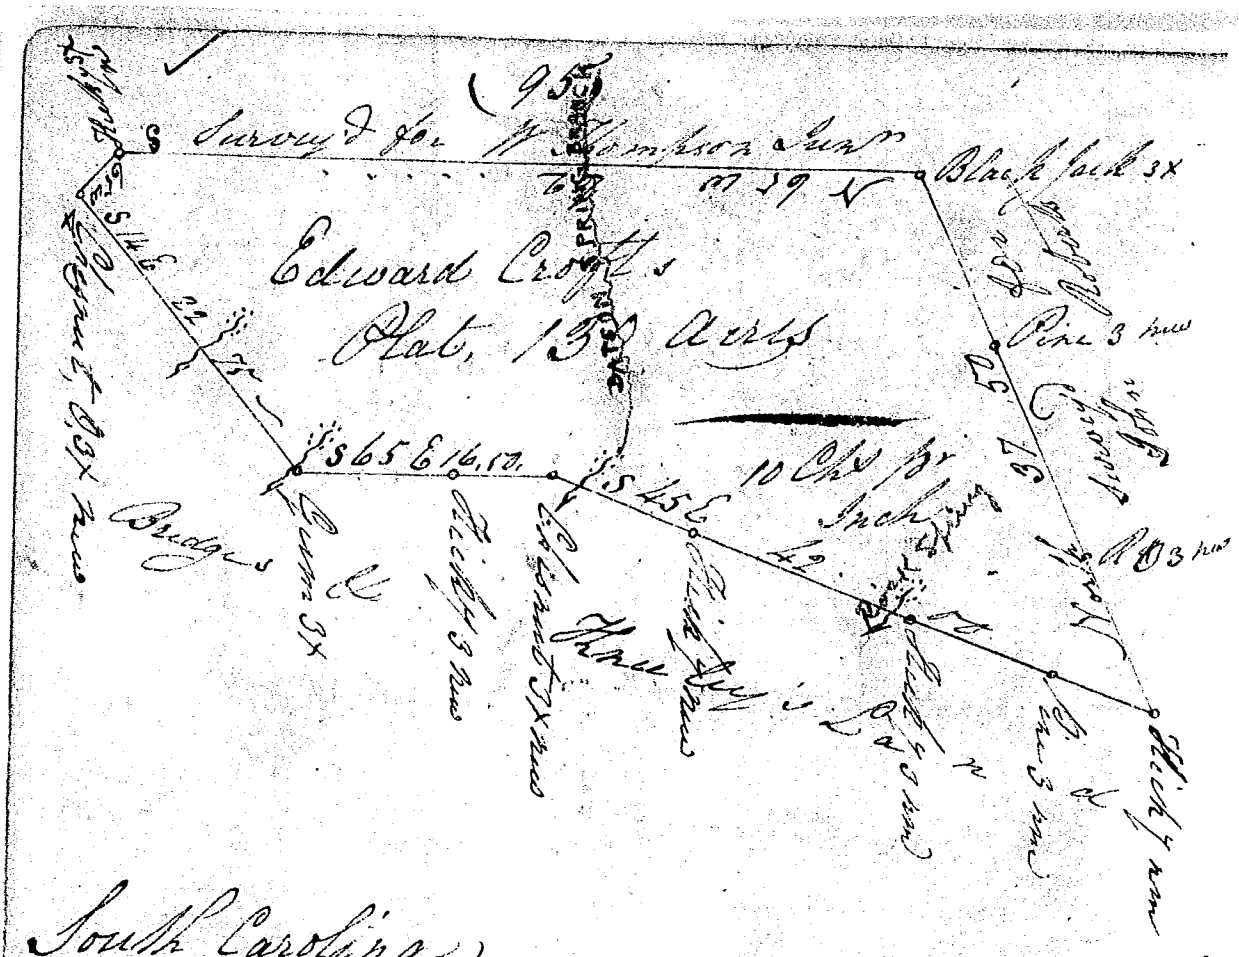

South Carolina
Greenville District } Pursuant to a warrant from
Location of said District, Bearing date the
14th of May 1825. I have admeasured and laid out
unto Edward Croft a tract of one hundred and
Fifty Acres of Land, situate in said District
on Branches of Reedy River, and on the South
Robs of Paris's Mountain. and hath such
Form and Marks as the above Plat Represents.
Surveyd the 25th of June 1825.
Philip Lester D.S.
Recorded the 12th day of July 1825.

John Young D.C.
Handed to his Boy by order