


Laid down by a scale of
20 Chs for Inch

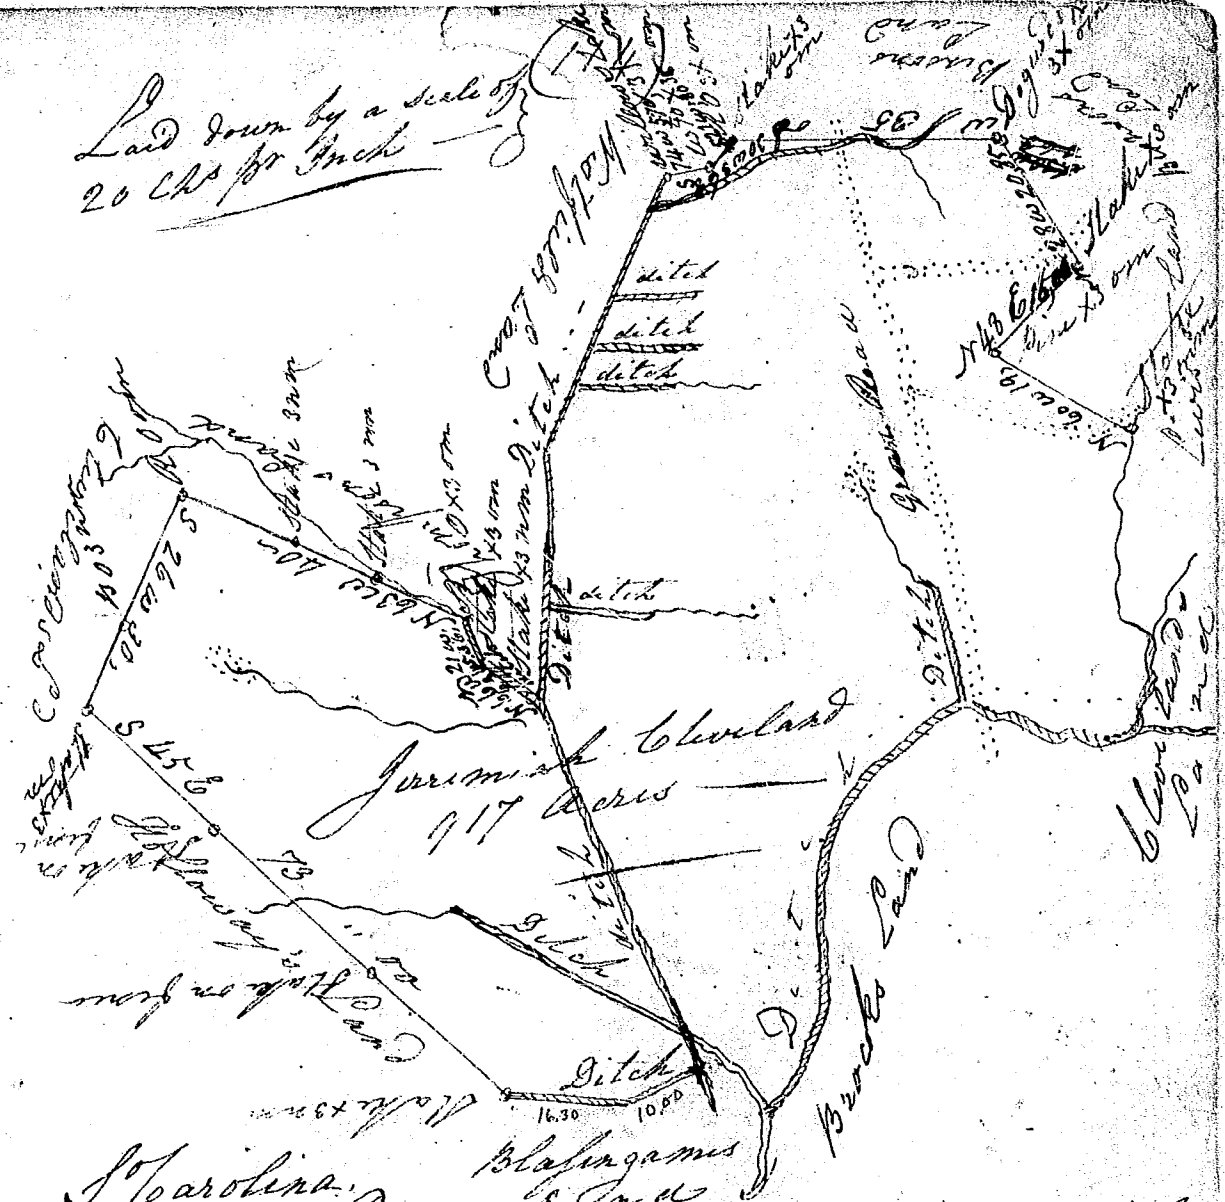

Blasingame
 Pursuant to a warrant from John
 Young Esq. Commr. of Locations in the District
 of Greenville dated the 3rd day of April 1830
 I have admeasured & laid out unto Jeremiah
 Cleveland a tract of nine hundred acres of
 land, situate in the said District on the
 Grove Creek waters of Saluda River; bounded
 as follows, N by Willis Binson NW by David
 Westfield's land W by Christian Thompson, and
 said Cleveland's land SW by Silas Halloway's land
 so by Wm E. Blasingame's land SE by Brock and
 Cleveland's lands E by Cleveland &
 Mary Lewis's lands, and hath such form &
 marks as the above plat exhibits.
 Surveyed the 28th of April 1830 by J. Cleveland
 Jr. - Recorded the 1st day of May 1830 by
 John Young Esq.

58 handed to self