216

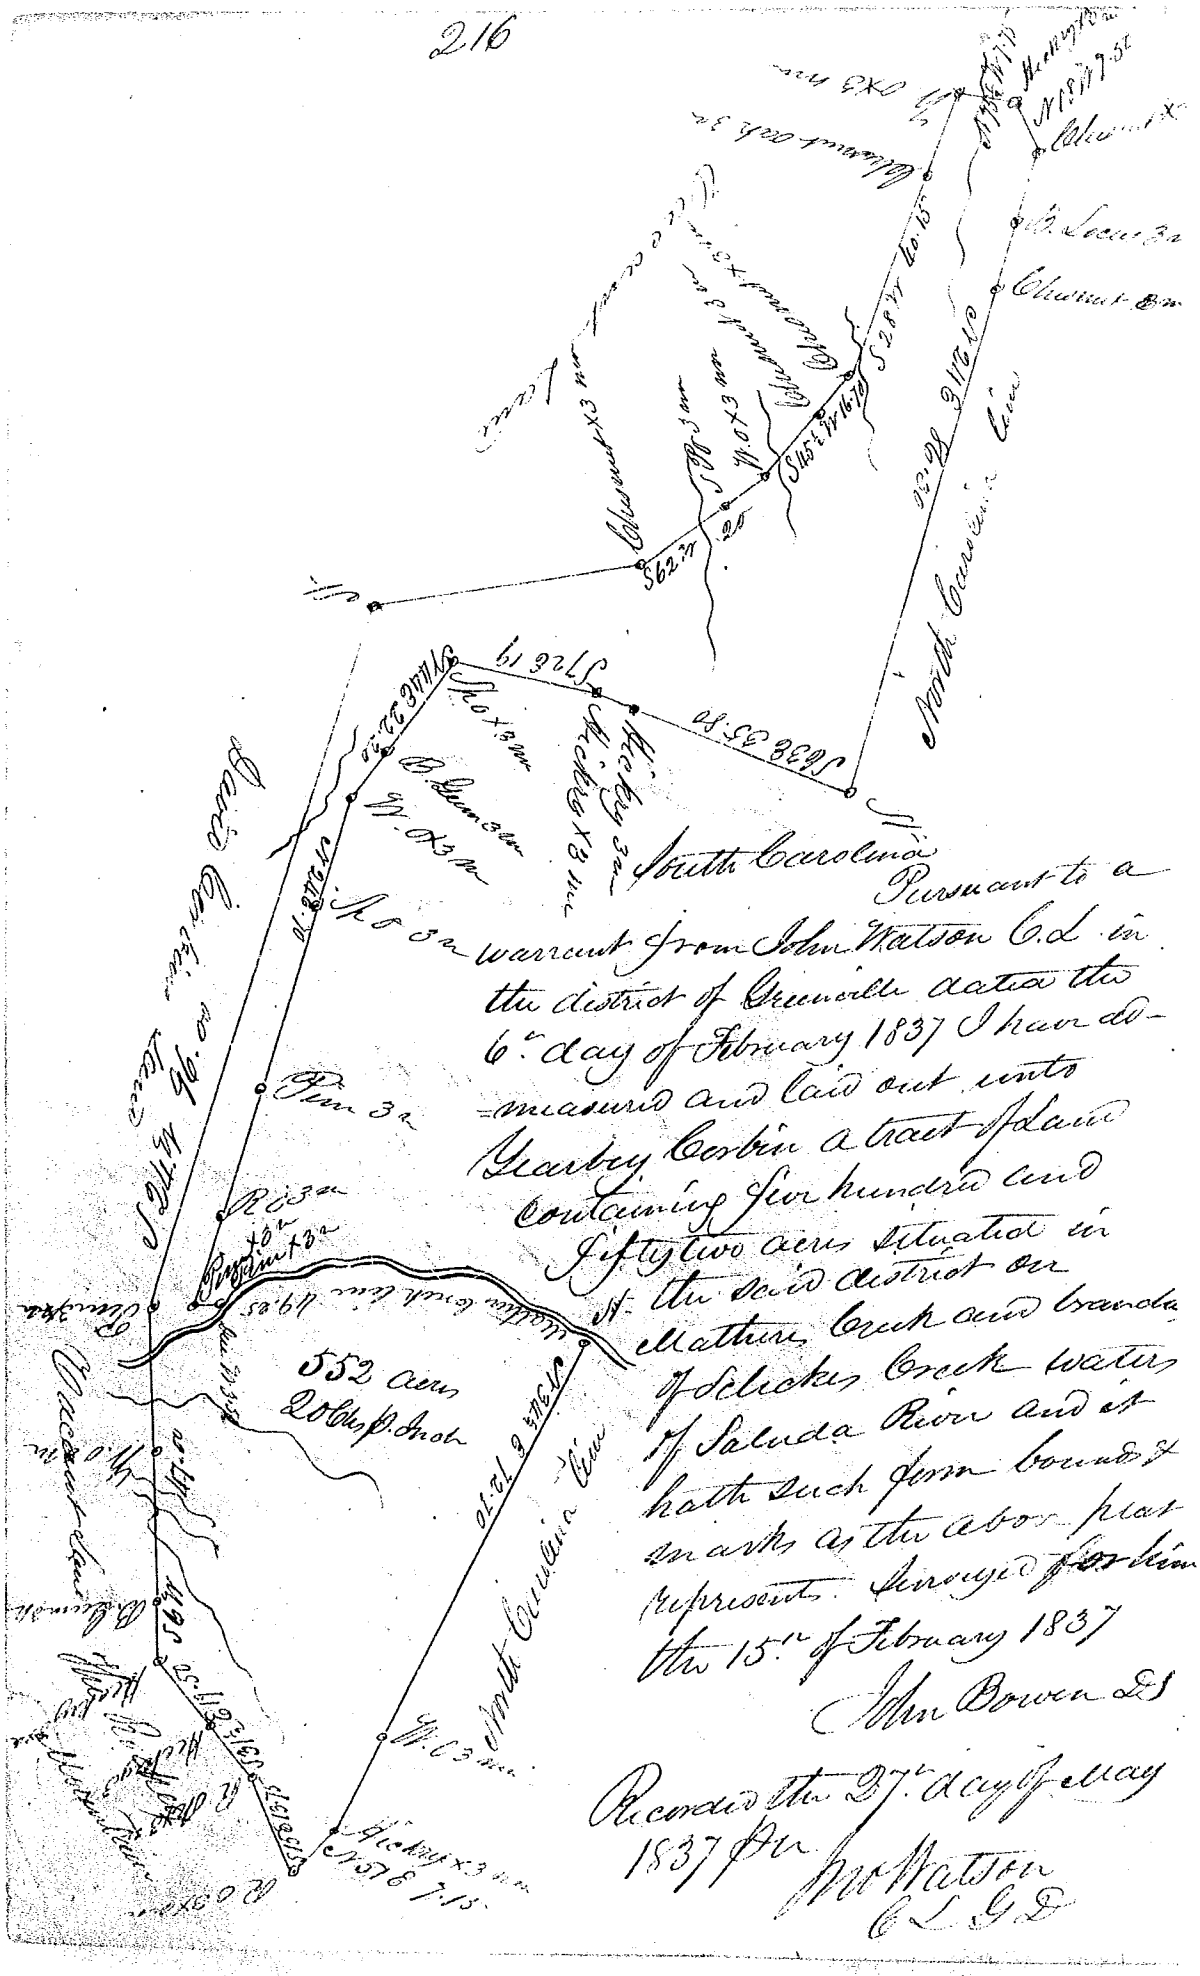

Pursuant to a
warrant from John Watson C.d. in
the district of Greenville dated the
6th day of February 1837 I have de-
-measured and laid out unto
Gearby Corbin a tract of land
containing five hundred and
fifty two acres situated in
the said district on
Mathus Creek and branches
of Reedy Creek waters
of Saluda River and it
hath such form boundes &
marks as the above plat
represents. Surveyed the 15th
the 15th of February 1837

John Bowen DS

Recorded the 27th day of May
1837 Per
Jno Watson
C.L.G.D