


# 8853 Filed This 13 day of Oct. 1970  
 And Recorded in Vol. 4H Page 55 at 4:17 P.  
 Ollie Farnsworth  
 Register Master Greenville County, S. C.

RECORDED  
 PAID 50

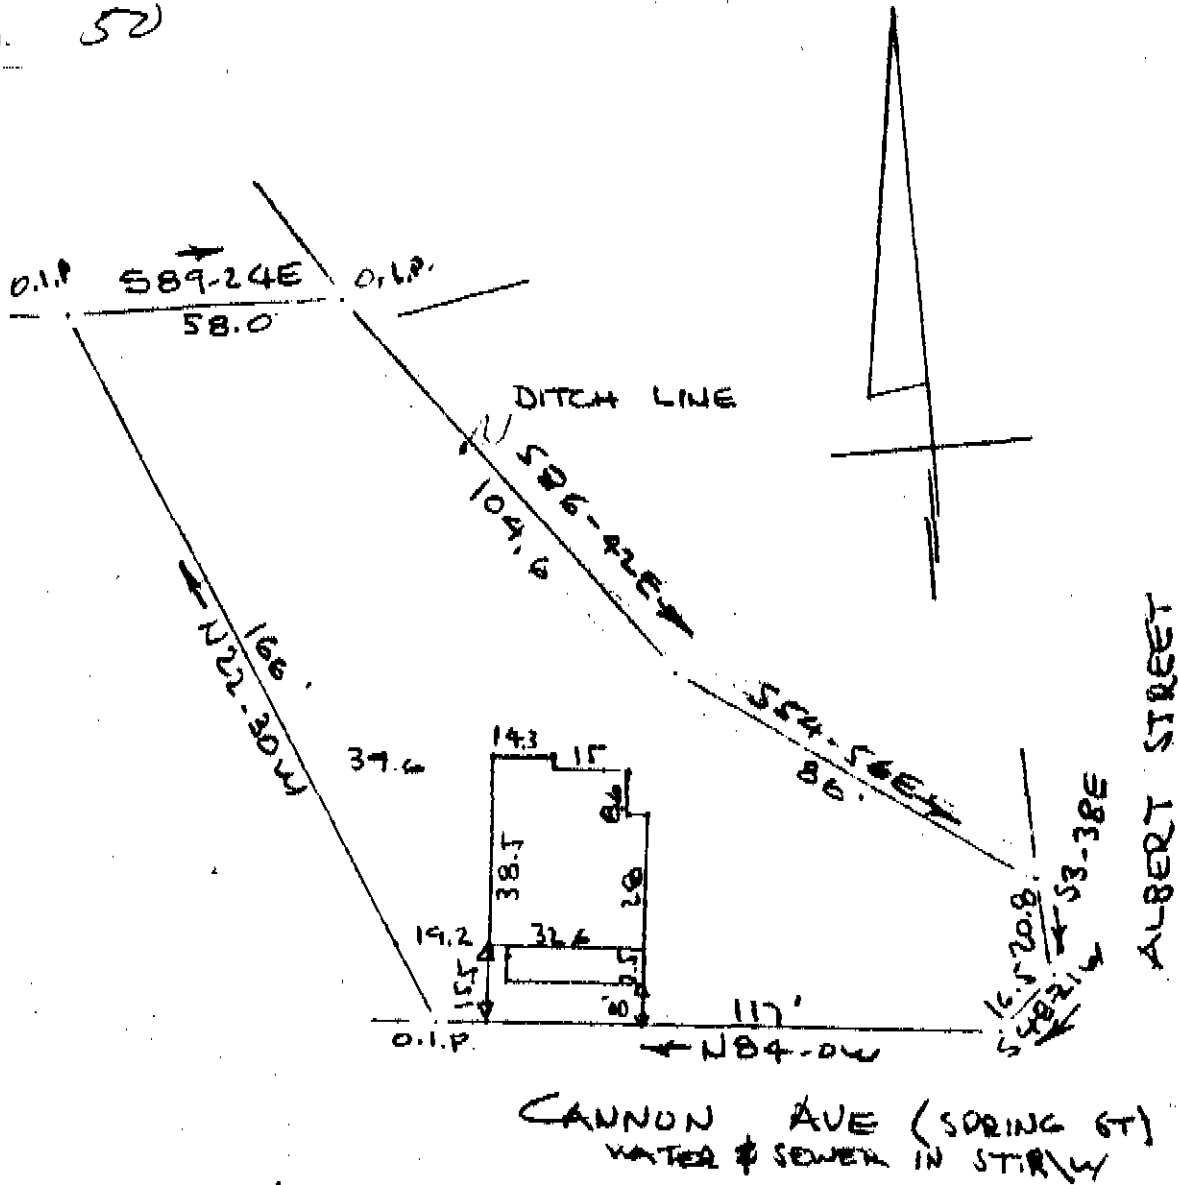

OCT 13 4 17 PM '70  
 OLLIE FARNSWORTH  
 R.M.C.

PROPERTY OF  
 DREXEL UNDERWOOD & LAURA P. UNDERWOOD  
 GREENVILLE S.C.  
 SCALE: 1" = 40' 10 OCT 1970

This is to certify that on the 10th day of October 1970, I surveyed the property shown on this plat, being known as PROPERTY OF DREXEL UNDERWOOD & LAURA P. UNDERWOOD and recorded in the RMC Office Greenville County, S.C., in Plat Book at Page ; and that the property lines, walls and buildings are as shown hereon, and that the walls and buildings located on said lot do not encroach or project on adjacent street or property, and that no adjacent walls or buildings encroach or project on said premises, and no power lines cross this property except as shown hereon.

4H-55

R. B. Bruce, R.L.S. #1952

CAROLINA SURVEYING COMPANY

8853 55  
 OCT 13 1970