


Plat Book 4H, Page 89 A

10598 Filed This 3rd Day of Nov. 1970
 And Recorded in Vol. 44 Page 89 at 9:39 P.M.
Ollie Farnsworth
 Register of Deeds Greenville County, S. C.

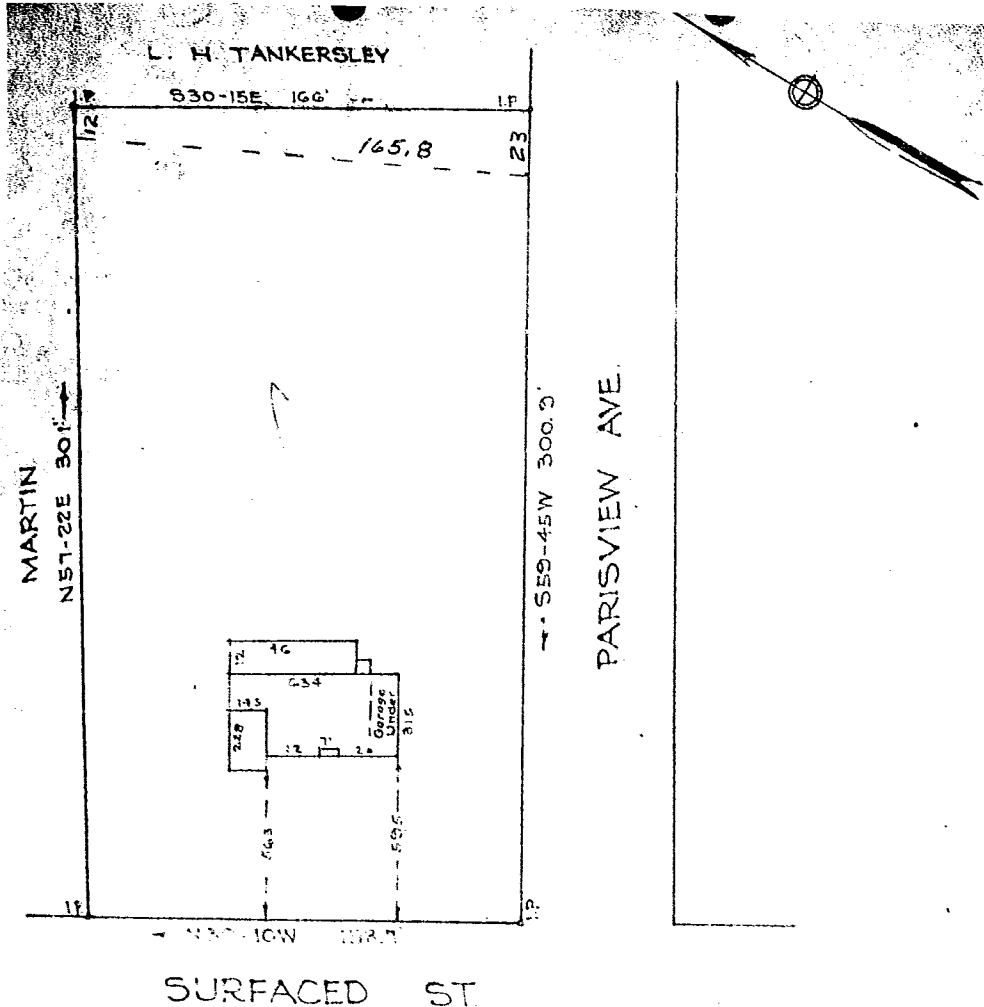

PROPERTY OF
 L. H. TANKERSLEY
 TRAVELERS REST S. C.
 Scale 1"=50' June 1955

This is to certify that on the 28th day of June, 1955, I surveyed the property shown on this plat; and that the property lines, walls and buildings are as shown hereon; that the buildings located on said lot do not encroach or project on adjacent streets or property; and that no adjacent buildings or walls encroach or project on said premises.

504 4H-89 ✓

R. W. Hutton
 Registered.

FILED NOV 3 9 38 AM '70
 GREENVILLE CO. S. C.
 OLLIE FARNSWORTH
 R. H. C.

10598

NOV 3 1970