


716315 Filed This 14 day of Jan 1971

And Recorded in Vol. 4, Page 197 of 316 M

Ollie Farnsworth
Register Mesne Conveyance Greenville County, S. C.

RECORD OF PLATS
PLATS 50

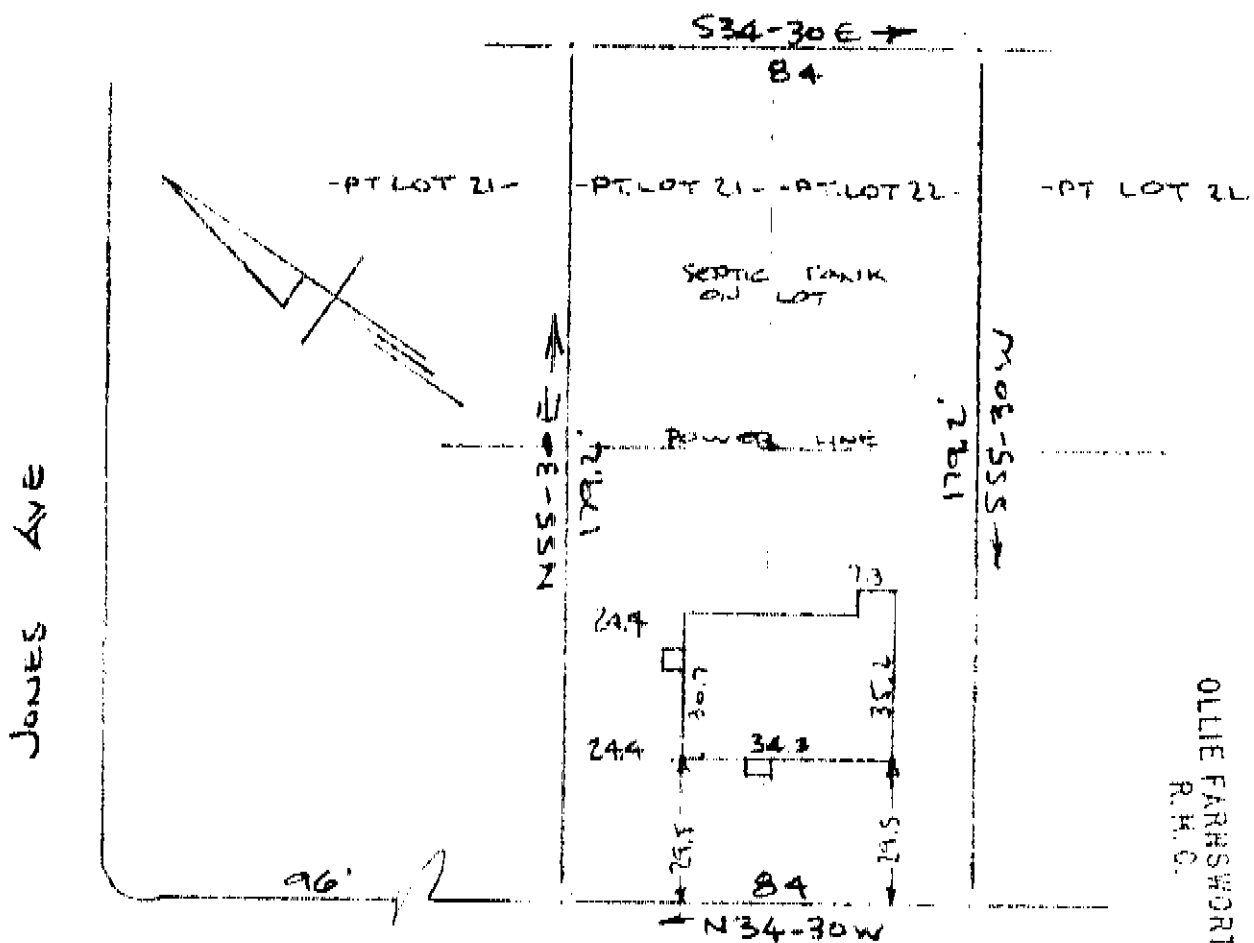

FILED
GREENVILLE CO. S. C.
JAN 14 2 16 PM '71
OLLIE FARNSWORTH
R.M.C.

VERNON STREET
WATER IN ST. RW

PROPERTY OF
BOBBY L. GARRETT
NEAR GREEN, S. C. - GREENVILLE CO
SCALE 1" = 40' (2 JAN 1971)

This is to certify that on the 12th day of January 1971, I surveyed the property shown on this plat, being known as part of lot 21 & part of lot 22 on plat of V. E. COX and recorded in the RMC Office Greenville County, S.C. in Plat Book "FP" at Page 78 and also being known as PROPERTY OF BOBBY L. GARRETT and recorded in Plat Book 4H at Page 197; and that the property lines, walls and buildings are as shown hereon, and that the walls and buildings located on said lots do not encroach or project on adjacent street or property, and that no adjacent walls or buildings encroach or project on said premises, and no power lines cross this property except as shown hereon.

R. B. Bruce, RLS #1952
16315

CAROLINA SURVEYING COMPANY
Greenville, S. C.

JAN 14 1971