


Magnetic North

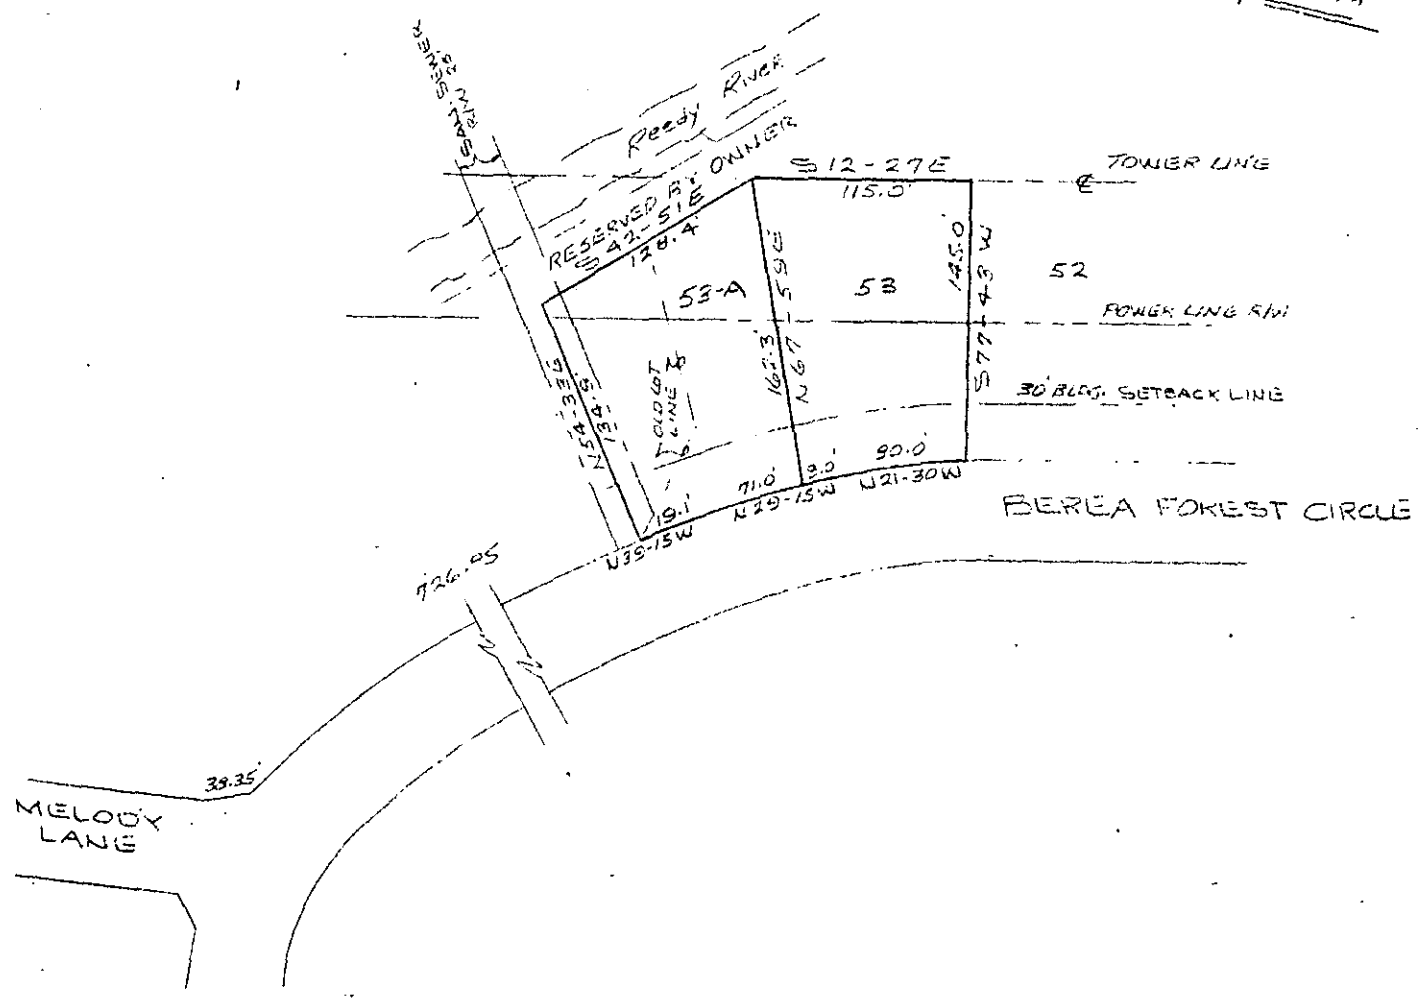

REVISION LOT NO. 53  
BERIA FOREST SECT. NO. 2  
 NEAR GREENVILLE, S. C.  
 SCALE 1"=100' OCT. 21, 1972.

NOTE:  
 5' UTILITY & DRAINAGE EASEMENT EACH SIDE  
 OF ALL SIDE & REAR LOT LINES.

13648

FILED  
 GREENVILLE CO. S. C.  
 NOV 6 3 57 PM 1972  
 REGISTERED  
 ELIZABETH R. DILLON, R.M.C.  
 LAND SUPERVISOR  
 JAMES D. CRAN  
 3320

RECORDING FEE  
 PAID \$ 100

PIEDMONT ENGINEERS and ARCHITECTS  
 GREENVILLE, S. C.

4-103-page, 40. ✓