

Note:

5' UTILITY & DRAINAGE EASE MENT. ALONG EACH 3106 & REAR LET LINES IN ACCITION TO EASEMENTS SHOWN ON PLATE ALL LOT CORNERS STAKED WITH IRON PINS.

9917 Filed This /6 day of Oct. 1914

And Recorded in Vol. EX Page 71 at 1:319 m

Donnie D. Jankersley

Register Mesne Conveyance Greenville County. 800


REVISED: 19/2/14 - BEARING CHANGES TO MATCH PLAT of SEC. TIL

CHILL TO BALL

OMEENAHTI 000 210

/4×-9

# 99/

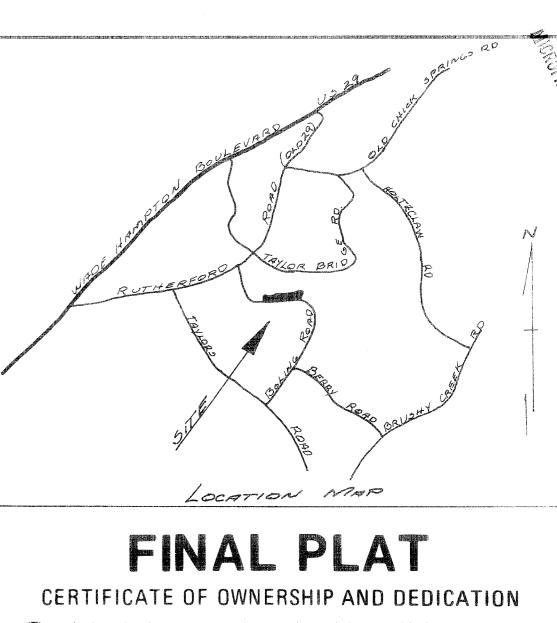

"The undersigned hereby acknowledge that I am (we are) the owner(s) of the property shown and described hereon and that I (we) hereby adopt this plan of subdivision with my (our) free consent and that I (we) establish the minimum building restriction lines, and hereby dedicate to public use as roads, streets, and easements, forever all areas so shown or indicated on said plat.

	se as 10	24/	Signed	Howard Warman Sala bis	
		/	Signed		

## CERTIFICATE OF ACCURACY

10/2/74	R.E. Blackman
DATE	LICENSED ENGINEER OR REGISTERED SURVEYOR

S. C Registration No. <u>5291</u>

NO. OF LOTS:/3

## CERTIFICATE OF APPROVAL FOR RECORDING

"I hereby certify that the subdivision plat shown hereon has been found to comply with the Subdivision Regulations for Greenville County, with the exception of such variances, if any, as are noted in the minutes of the Greenville County Planning Commission of Greenville County, South Carolina, and that it has been approved for recording in the office of the County Register of Mense Conveyance."

| DIRECTOR OF PLANNING COMMISSION

REVISED

## FILE NUMBER

SECTION F						
COPA WIE W	5 08 0141 5100					
WESTMINSTER CO. OWN TR	HEANER ENGR. CO., THE					
NO. OF 'CRES: 3.4	MILES O.12					

				177 1007 1 = 100		
1 <b>0</b> 0	50	6	100	200	300	

DATE: 10/2/74