MICROFILMED

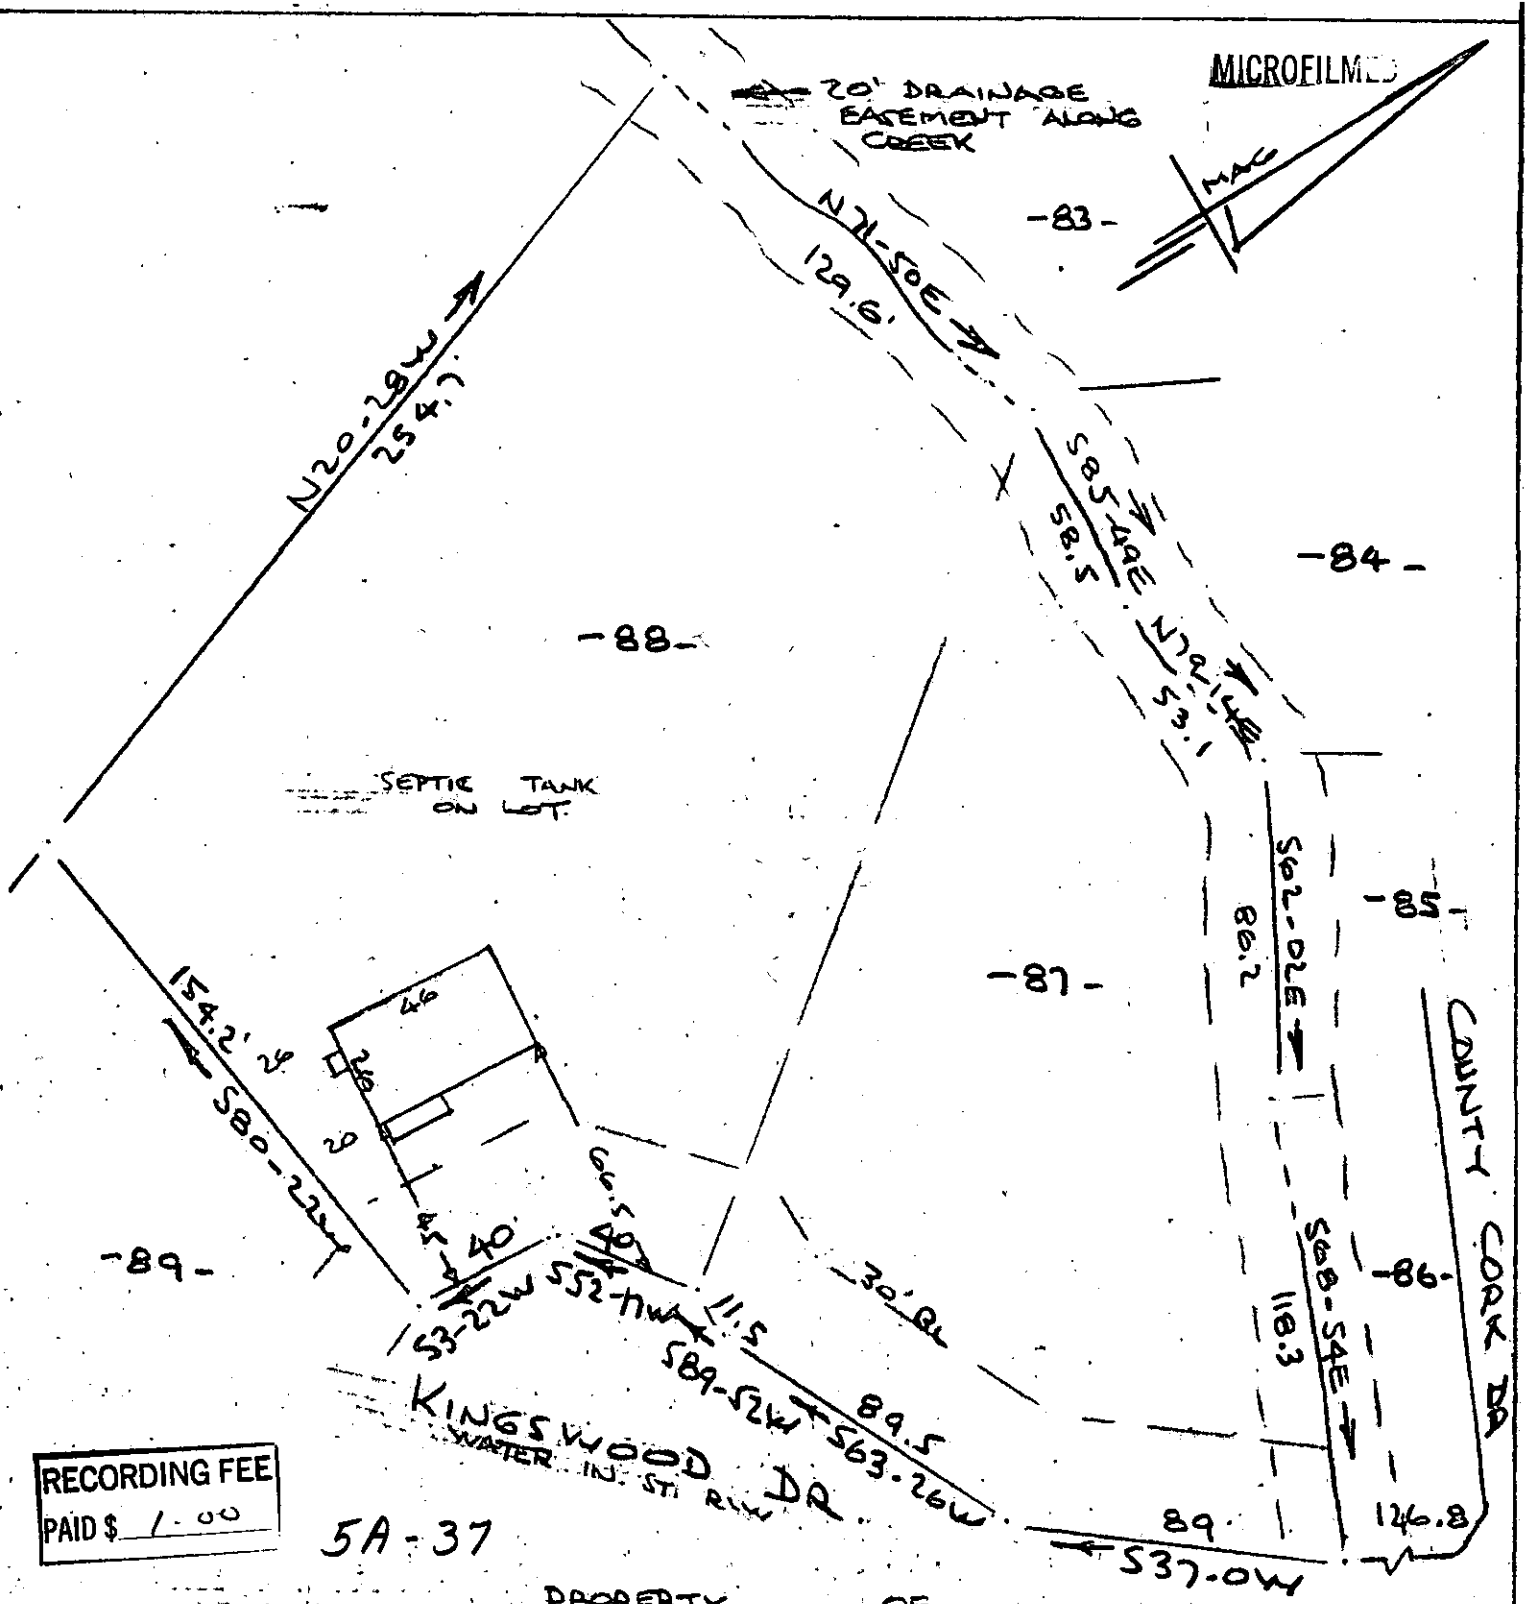

RECORDING FEE
PAID $ 1.00

PROPERTY OF
DONALD BRUCE THOMPSON & DONNA K. THOMPSON
NEAR GREENVILLE, S. C.
SCALE 1" = 50' 31 MAY 1973

T
This is to certify that on the 31st day of May 1973 I surveyed the property shown on this plat being known as lots 87 & 88 o n plat of Revision Of SHAMROCK ACRES and recorded in the R.M.C. Office Greenville County S.C. in plat book "RR" page 133; and that the property lines walls and buildings are as shown hereon, and that the buildings located on said lot do not encroach or project on adjacent street or property and that no adjacent buildings or walls encroach or project on said premises and that no power lines cross cross said property except as shown hereon.

JUN 4 1973

R. B. Bruce
R.B.Bruce R.L.S. #1952.

124154

34943