


FILED
GREENVILLE CO. S. C.

JUN 7 4 27 PM '73

DONNIE S. TANKERSLEY
R.M.C.

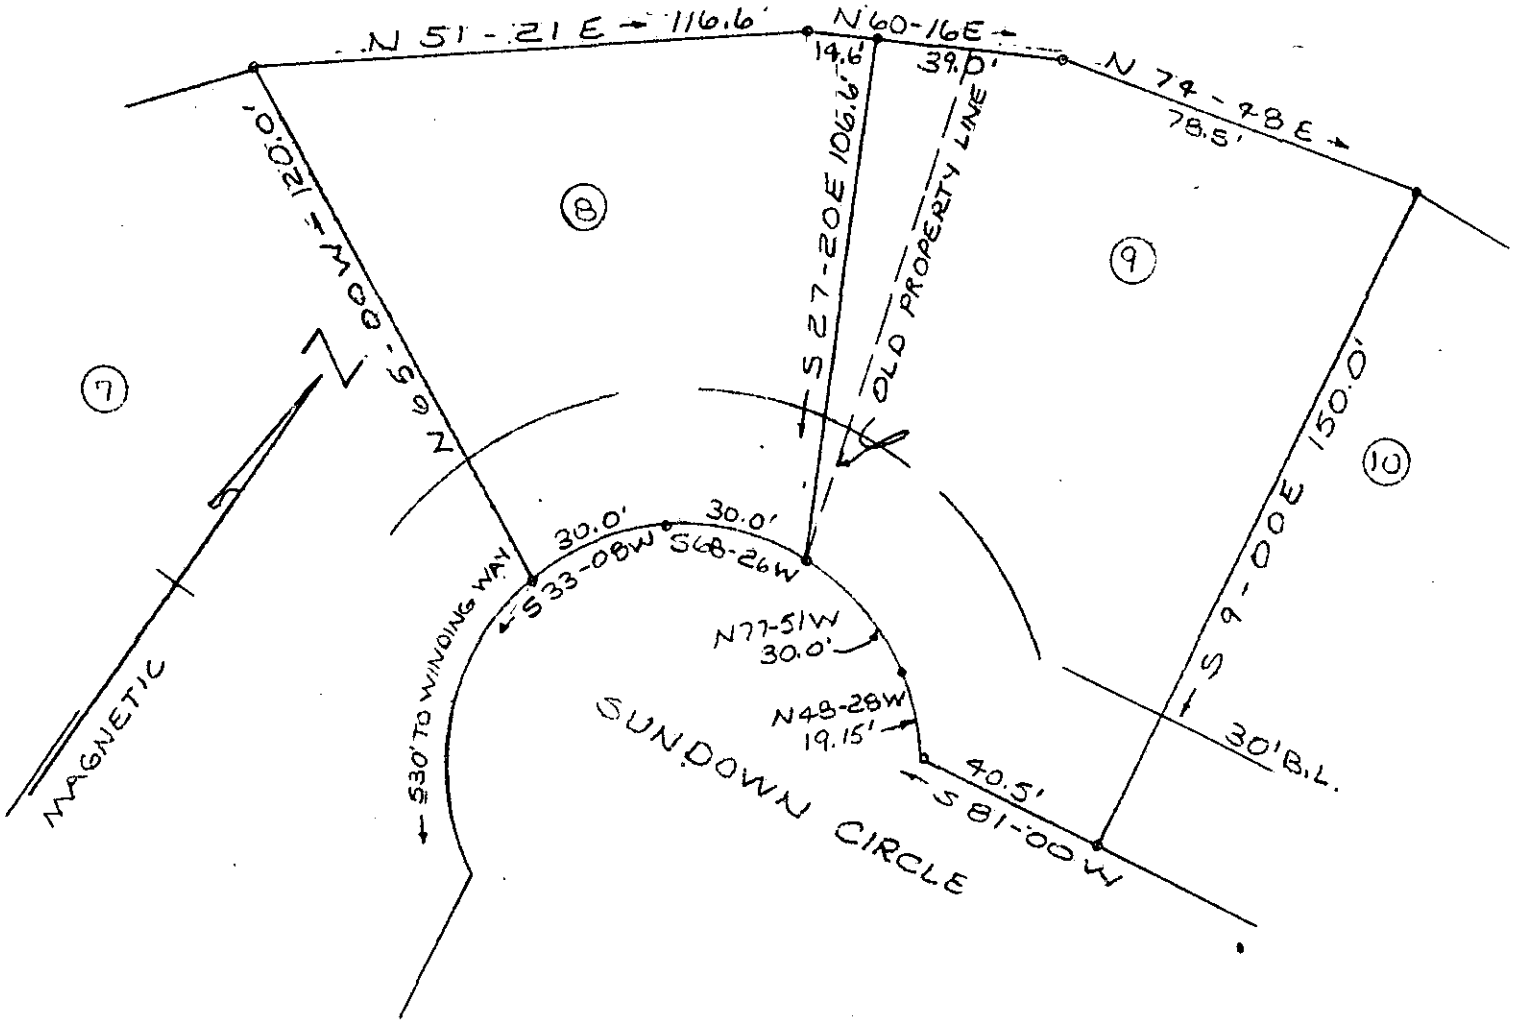

REVISION OF
LOTS 8 & 9 SEC. I PEPPERTREE

NEAR GREENVILLE, S.C.

JUNE 9, 1973

SCALE 1" = 40'

JUN 7 1973

BY: CAMPBELL & CLARKSON
SURVEYORS, INC.

R. D. Woollen, Jr.
S.C. R.L.S. NO. 4678

5-A 51

RECORDING FEE
PAID \$ 1.00

35393