
MICROFILMEL

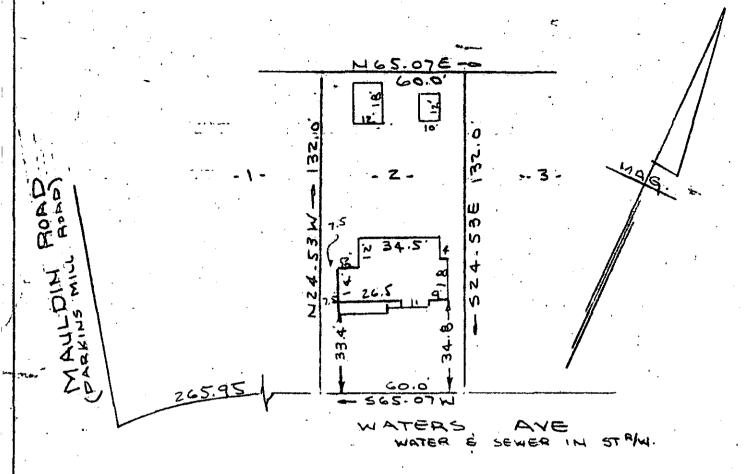

PROPERTY OF
KIRK D. NASON
GREENVILLE, S.C.
SCALE 1"= 40 31 AUG 1973

This is to certify that on the 31st day of August 1973, I surveyed the property shown on this plat, being known as lot 2 on plat of PICKWICK HEIGHTS and recorded in the RMC Office Greenville County, S.C., in Plat Book "X" at Page 141; and that the property lines, walls and buildings are as shown hereon, and that the walls and buildings located on said lot do not encroach or project on adjacent street or property, and that no adjacent walls or buildings encroach or project on said premises, and no power lines cross this property except as shown hereon.

R. B. Bruce, RLS #1952

DENNIE STANKERSLEY

SEP 4 4 02 PH 73

CREENVILLE, CO. S. C.

RECORDING FEE

CAROLINA SURVEYING CO.

6692 Manly St.
Greenville, S. C.

SEP 4 1973