


MICROFILMED

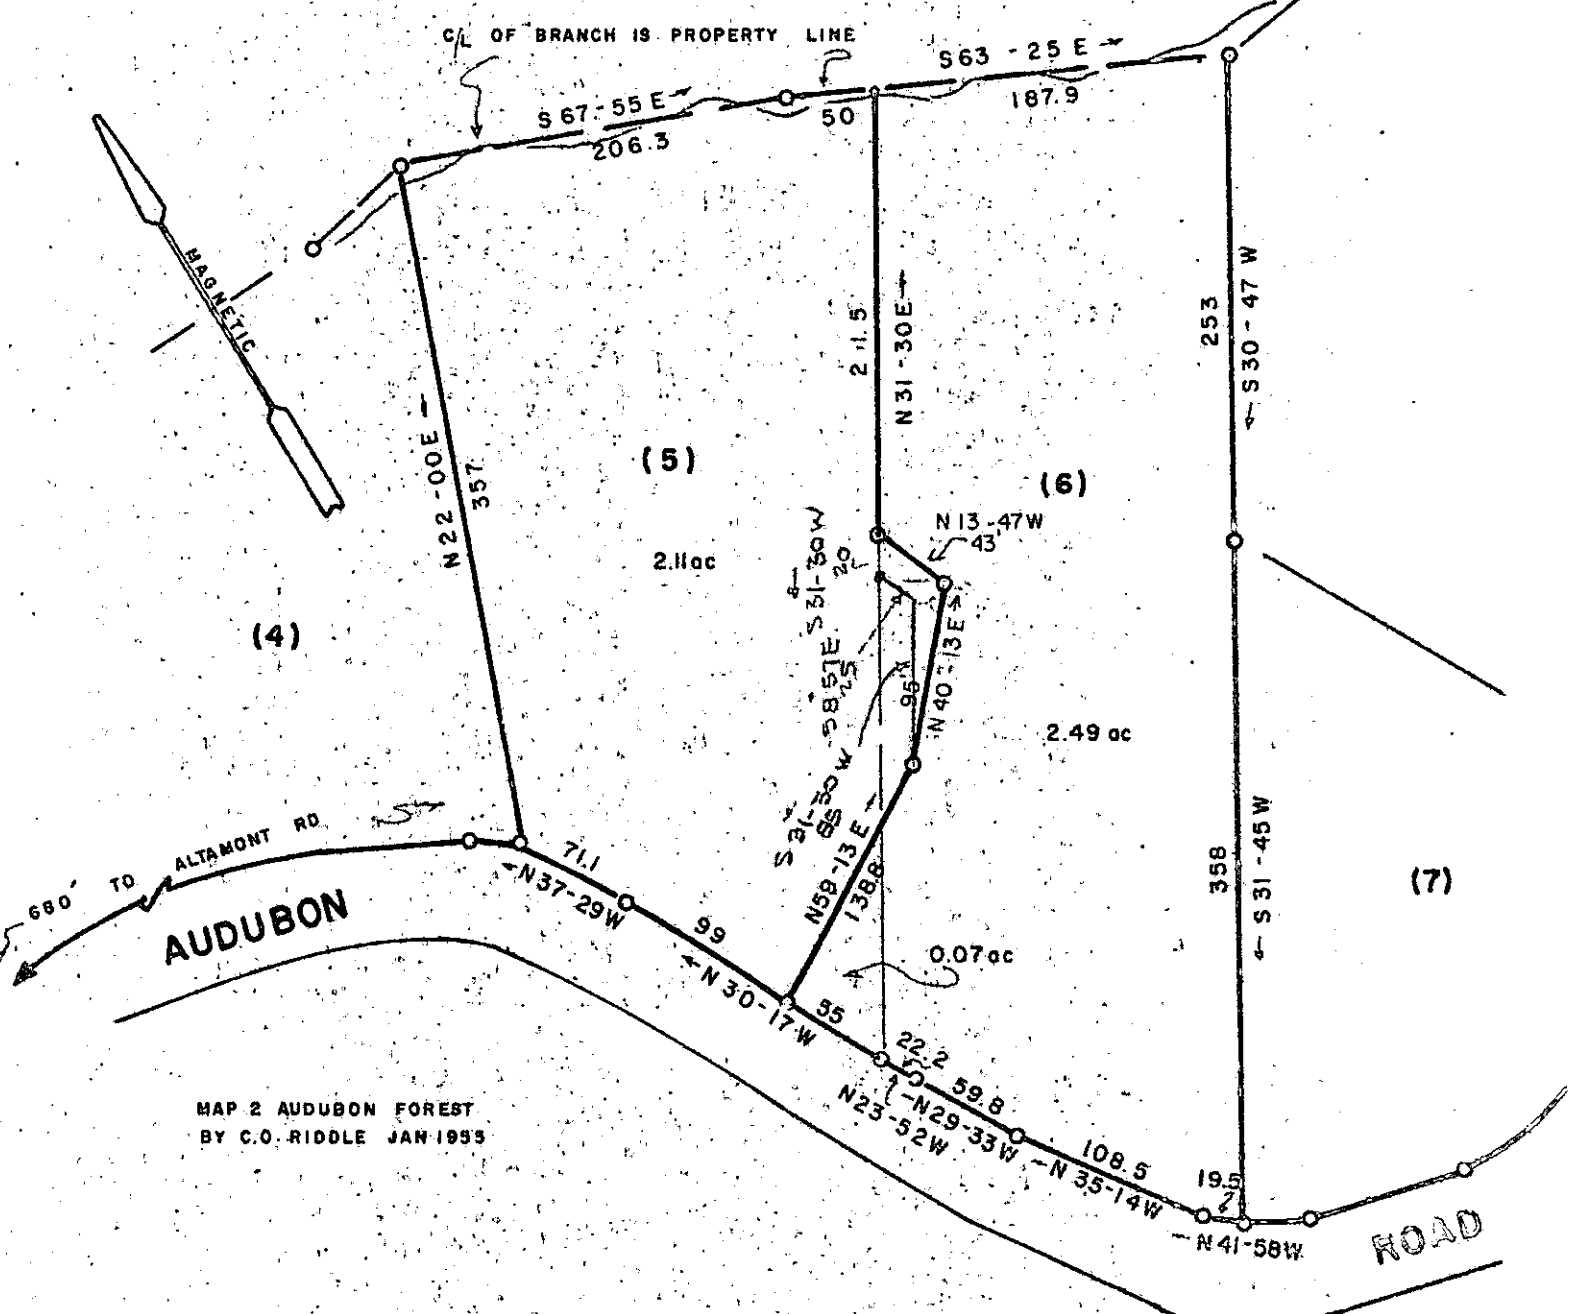

MAP 2 AUDUBON FOREST BY C.O. RIDDLE JAN 1955

FILED GREENVILLE CO. S.C. OCT 22 10 40 AM '73 DONNIE S. TANKERSLEY R.M.C.

REVISION OF LOTS 5 & 6 AUDUBON FOREST

GREENVILLE COUNTY S.C. SCALE 1" = 100' MAY 30, 1973 REVISED OCT. 5, 1973

5C-95

OCT 22 1973 11048

RECORDING FEE PAID \$ 1.00