


EAST SOMERSET AVE
WATER & SEWER IN ST. R/W

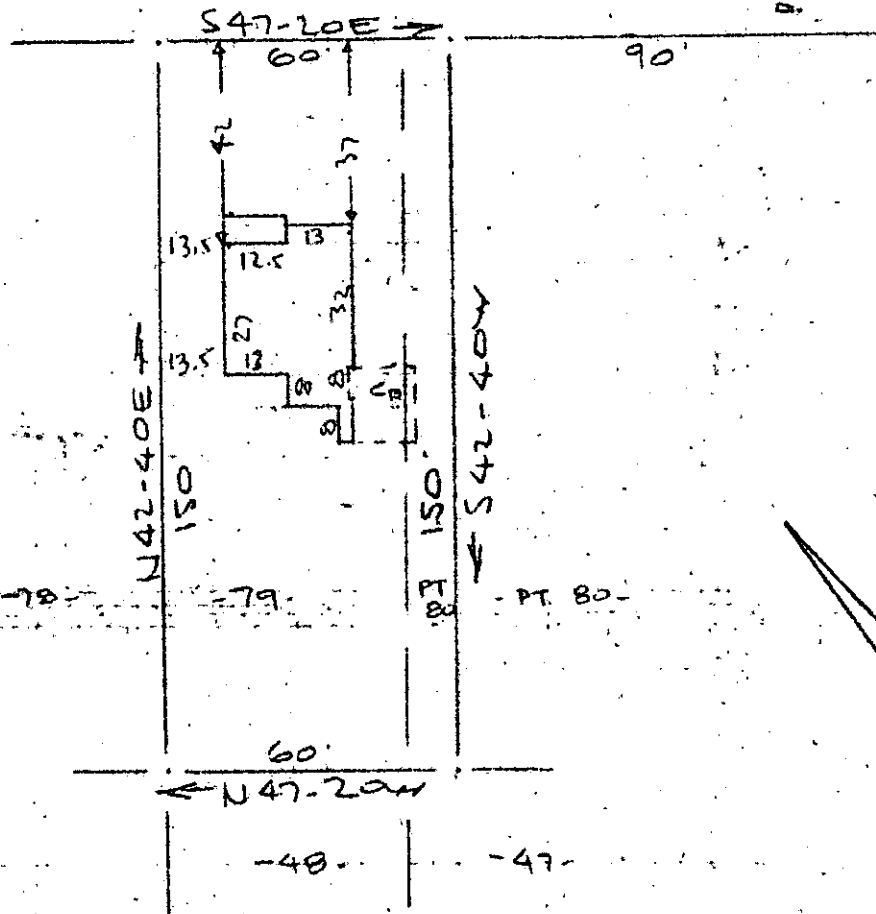

PROPERTY OF
 CHARLES G. BROWN JR.
 NEAR GREENVILLE, S.C.
 SCALE: 1" = 40' 14 NOV 1973

FILED
 GREENVILLE CO. S.C.
 NOV 16 3 30 PM '73
 DONNIE S. TANKERSLEY
 R.M.C.

This is to certify that on the 14th day of November 1973, I surveyed the property shown on this plat, being known as lot 79 & part of lot 80 on plat of ANDERSON STREET HIGHLANDS and recorded in the RMC Office Greenville County, S.C., in Plat Book "J" at Page 157; and that the property lines, walls and buildings are as shown hereon, and that the walls and buildings located on said lot do not encroach or project on adjacent street or property, and that no adjacent walls or buildings encroach or project on said premises, and no power lines cross this property except as shown hereon.

R. B. Bruce
 R. B. Bruce, RLS #1952

5C-131

CAROLINA SURVEYING CO.
 112 Manly St.
 Greenville, S.C.

RECORDING FEE
 PAID \$ 1.00

NOV 16 1973